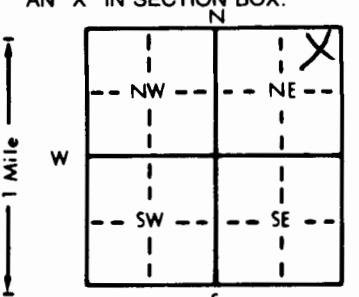


1 LOCATION OF WATER WELL: County: <u>SEDGWICK</u>	Fraction <u>NE NE 1/4 NE 1/4</u>	Section Number <u>7</u>	Township Number <u>T 28 S</u>	Range Number <u>R 1 E</u>
--	----------------------------------	-------------------------	-------------------------------	---------------------------

Distance and direction from nearest town or city street address of well if located within city?

2 WATER WELL OWNER: RR#, St. Address, Box # : <u>Birchwood Ctr</u> <u>1301 W. 31st S.</u> City, State, ZIP Code : <u>Wichita, KS</u>	MW2 Board of Agriculture, Division of Water Resources Application Number:
---	---

3 LOCATE WELL'S LOCATION WITH AN "X" IN SECTION BOX: 	4 DEPTH OF COMPLETED WELL: <u>15</u> ft. ELEVATION: <u>127.15</u> Depth(s) Groundwater Encountered 1. ft. 2. ft. 3. ft. WELL'S STATIC WATER LEVEL ft. below land surface measured on mo/day/yr Pump test data: Well water was ft. after hours pumping gpm Est. Yield gpm: Well water was ft. after hours pumping gpm Bore Hole Diameter in. to ft., and in. to ft. WELL WATER TO BE USED AS: 5 Public water supply 8 Air conditioning 11 Injection well 1 Domestic 3 Feedlot 6 Oil field water supply 9 Dewatering 12 Other (Specify below) 2 Irrigation 4 Industrial 7 Lawn and garden only 10 Monitoring well Was a chemical/bacteriological sample submitted to Department? Yes <u>No</u> ; If yes, mo/day/yr sample was submitted Water Well Disinfected? Yes <u>No</u>
--	--

5 TYPE OF BLANK CASING USED: 1 Steel 3 RMP (SR) 5 Wrought iron 8 Concrete tile CASING JOINTS: Glued Clamped 2 PVC 4 ABS 6 Asbestos-Cement 9 Other (specify below) <u>Welded</u> Blank casing diameter in. to <u>15</u> ft., Dia in. to ft., Dia in. to ft. Casing height above land surface in., weight lbs./ft. Wall thickness or gauge No. TYPE OF SCREEN OR PERFORATION MATERIAL: 1 Steel 3 Stainless steel 5 Fiberglass 8 RMP (SR) 10 Asbestos-cement 2 Brass 4 Galvanized steel 6 Concrete tile 9 ABS 11 Other (specify) 12 None used (open hole) SCREEN OR PERFORATION OPENINGS ARE: 1 Continuous slot 3 Mill slot 5 Gauzed wrapped 8 Saw cut 11 None (open hole) 2 Louvered shutter 4 Key punched 7 Torch cut 9 Drilled holes 10 Other (specify) SCREEN-PERFORATED INTERVALS: From <u>5</u> ft. to <u>15</u> ft., From ft. to ft. GRAVEL PACK INTERVALS: From <u>4</u> ft. to <u>15</u> ft., From ft. to ft.
--

6 GROUT MATERIAL: 1 Neat cement 2 Cement grout 3 Bentonite 4 Other Grout Intervals: From <u>0</u> ft. to <u>6"</u> X From <u>6"</u> ft. to <u>4</u> ft., From ft. to ft. What is the nearest source of possible contamination: 1 Septic tank 4 Lateral lines 7 Pit privy 10 Livestock pens 14 Abandoned water well 2 Sewer lines 5 Cess pool 8 Sewage lagoon 11 Fuel storage 15 Oil well/Gas well 3 Watertight sewer lines 6 Seepage pit 9 Feedyard 12 Fertilizer storage 16 Other (specify below) 13 Insecticide storage Direction from well? How many feet?
--

FROM	TO	LITHOLOGIC LOG	FROM	TO	PLUGGING INTERVALS
0	6"	Fill			
6"	5'	Sand, Silty			
5'	9'	Clay, Brown, Silty			
9'	14.5'	Silty, Sandy Gray			
14.5'	15'	Sand - Fine - Mud.			

7 CONTRACTOR'S OR LANDOWNER'S CERTIFICATION: This water well was (1) constructed, (2) reconstructed, or (3) plugged under my jurisdiction and was completed on (mo/day/year) <u>4/19/93</u> and this record is true to the best of my knowledge and belief. Kansas Water Well Contractor's License No. <u>483</u> This Water Well Record was completed on (mo/day/yr) <u>6/30/93</u> under the business name of <u>TEST</u> by (signature) <u>Ray P. Day</u>
--