


1 LOCATION OF WATER WELL:	Fraction	Section Number	Township Number	Range Number
County: Sedwick	SE $\frac{1}{4}$ NW $\frac{1}{4}$ NW $\frac{1}{4}$	17	T 28 S	R 1 E

Distance and direction from nearest town or city street address of well if located within city?

1700' SE of Seneca and MacArthur, Wichita, Ks.

2	WATER WELL OWNER:	Oxy, Inc.	
	RR#, St. Address, Box # :	P.O. Box 300	Board of Agriculture, Division of Water Resources
	City, State, ZIP Code :	Tulsa, OK 74102	Application Number:

3	LOCATE WELL'S LOCATION WITH AN "X" IN SECTION BOX:	4	DEPTH OF COMPLETED WELL	20	ft.	ELEVATION:	approx. 1280 MSL
			Depth(s) Groundwater Encountered	1	ft.	2	ft.

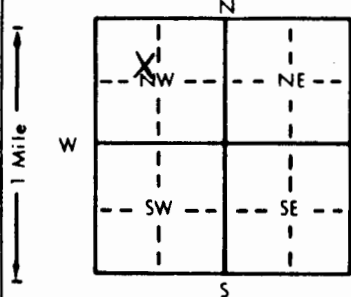

4 DEPTH OF COMPLETED WELL 20 ft. ELEVATION: approx. 1280 MSL

Depth(s) Groundwater Encountered 1. ft. 2. ft. 3. ft.

WELL'S STATIC WATER LEVEL 11.68 ft. below TOC measured on mo/day/yr 05-23-94

Pump test data: Well water was ft. after hours pumping gpm

Est. Yield gpm: Well water was ft. after hours pumping gpm

Bore Hole Diameter. 8 in. to 20 ft., and in. to ft.

WELL WATER TO BE USED AS:

1 Domestic	3 Feedlot	6 Oil field water supply	9 Dewatering	12 Other (Specify below)
2 Irrigation	4 Industrial	7 Lawn and garden only	10 Monitoring well	

Was a chemical/bacteriological sample submitted to Department? Yes No ☒ If yes, mo/day/yr sample was submitted

Water Well Disinfected? Yes No ☒

5 TYPE OF BLANK CASING USED:		3 Wrought iron	8 Concrete tile	CASING JOINTS: Glued Clamped	
1 Steel	3 RMP (SR)	6 Asbestos-Cement	9 Other (specify below)	Welded	
2 PVC	4 ABS	7 Fiberglass		Threaded	X
Blank casing diameter 2 in. to 5 ft., Dia in. to ft., Dia in. to ft.					
Casing height above land surface 24 in., weight lbs./ft. Wall thickness or gauge No. sch. 40					
TYPE OF SCREEN OR PERFORATION MATERIAL:					
1 Steel	3 Stainless steel	5 Fiberglass	7 PVC	10 Asbestos-cement	
2 Brass	4 Galvanized steel	6 Concrete tile	8 RMP (SR)	11 Other (specify)	
			9 ABS	12 None used (open hole)	
SCREEN OR PERFORATION OPENINGS ARE:					
1 Continuous slot	3 Mill slot	5 Gauzed wrapped	8 Saw cut	11 None (open hole)	
2 Louvered shutter	4 Key punched	6 Wire wrapped	9 Drilled holes		
		7 Torch cut	10 Other (specify)		
SCREEN-PERFORATED INTERVALS: From 5 ft. to 20 ft., From ft. to ft.					
From ft. to ft., From ft. to ft.					
GRAVEL PACK INTERVALS: From 3 ft. to 20 ft., From ft. to ft.					
From ft. to ft., From ft. to ft.					

6 GROUT MATERIAL: 1 Neat cement 2 Cement grout 3 Bentonite 4 Other
Grout Intervals: From 0 ft. to 1 ft., From 1 ft. to 3 ft., From ft. to ft.
What is the nearest source of possible contamination:
1 Septic tank 4 Lateral lines 7 Pit privy 10 Livestock pens 14 Abandoned water well
2 Sewer lines 5 Cess pool 8 Sewage lagoon 11 Fuel storage 15 Oil well/Gas well
3 Watertight sewer lines 6 Seepage pit 9 Feedyard 12 Fertilizer storage 16 Other (specify below)
former refinery
Direction from well? north How many feet? 500

[illegible]

7 CONTRACTOR'S OR LANDOWNER'S CERTIFICATION: This water well was (1) constructed, (2) reconstructed, or (3) plugged under my jurisdiction and was completed on (mo/day/year) 05-04-94 and this record is true to the best of my knowledge and belief. Kansas Water Well Contractor's License No. 527 This Water Well Record was completed on (mo/day/yr) 06-16-94 under the business name of GebCore Services, Inc. by (signature) [Signature]

INSTRUCTIONS: Use typewriter or ball point pen. PLEASE PRESS FIRMLY and PRINT clearly. Please fill in blanks, underline or circle the correct answers. Send top three copies to Kansas Department of Health and Environment, Bureau of Water, Topeka, Kansas 66620-0001. Telephone: 913-296-5545. Send one to WATER WELL OWNER and retain one for your records.