


1 LOCATION OF WATER WELL:	Fraction	Section Number	Township Number	Range Number
County: <u>Sedgwick</u>	<u>1/4</u> <u>1/4</u> <u>1/4</u>	<u>8</u>	T <u>28</u> S	R <u>1</u> <u>EW</u>

Distance and direction from nearest town or city street address of well if located within city?

3440 Southwood Ct., Wichita, KS. 67216

2 WATER WELL OWNER:	Board of Agriculture, Division of Water Resources
RR#, St. Address, Box # : <u>3440 Southwood Ct.</u>	Application Number:
City, State, ZIP Code : <u>Wichita, KS. 67216</u>	

3 LOCATE WELL'S LOCATION WITH AN "X" IN SECTION BOX:	4 DEPTH OF COMPLETED WELL: <u>22</u> ft. ELEVATION:
--	---

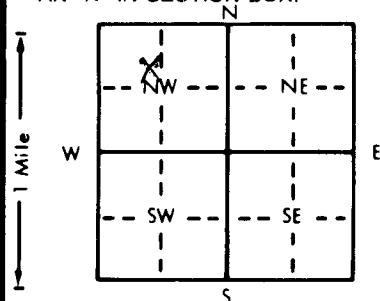

Depth(s) Groundwater Encountered	1. <u>14</u> ft.	2. <u>22</u> ft.	3. <u>22</u> ft.
WELL'S STATIC WATER LEVEL	<u>7-2-94</u>		
Pump test data: Well water was	ft. after	hours pumping	gpm
Est. Yield	gpm: Well water was	ft. after	hours pumping
Bore Hole Diameter	in. to	ft. and	in. to
WELL WATER TO BE USED AS:	5 Public water supply	8 Air conditioning	11 Injection well
1 Domestic	3 Feedlot	6 Oil field water supply	9 Dewatering
2 Irrigation	4 Industrial	7 Lawn and garden only	10 Monitoring well
Was a chemical/bacteriological sample submitted to Department? Yes.....No.....; If yes, mo/day/yr sample was submitted			
Water Well Disinfected? Yes.....No.....			

5 TYPE OF BLANK CASING USED:	5 Wrought iron	8 Concrete tile	CASING JOINTS: Glued.....Clamped.....
1 Steel	3 RMP (SR)	6 Asbestos-Cement	9 Other (specify below)
2 PVC	4 ABS	7 Fiberglass	10 Asbestos-cement
Blank casing diameter	<u>1.50</u> in. to	ft. Dia	11 Other (specify)
Casing height above land surface	<u>6 ft. Below</u>	lbs./ft. Wall thickness or gauge No.	12 None used (open hole)

TYPE OF SCREEN OR PERFORATION MATERIAL:	7 PVC	10 Asbestos-cement
1 Steel	3 Stainless steel	5 Fiberglass
2 Brass	4 Galvanized steel	6 Concrete tile
SCREEN OR PERFORATION OPENINGS ARE:	5 Gauzed wrapped	8 Saw cut
1 Continuous slot	3 Mill slot	6 Wire wrapped
2 Louvered shutter	4 Key punched	7 Torch cut
SCREEN-PERFORATED INTERVALS:	From	ft. to
GRAVEL PACK INTERVALS:	From	ft. to


6 GROUT MATERIAL:	1 Neat cement	2 Cement grout	3 Bentonite	4 Other
Grout Intervals:	From	ft. to	ft. to	ft. to
What is the nearest source of possible contamination:	10 Livestock pens	14 Abandoned water well	15 Oil well/Gas well	16 Other (specify below)
1 Septic tank	4 Lateral lines	7 Pit privy	11 Fuel storage	12 Fertilizer storage
2 Sewer lines	5 Cess pool	8 Sewage lagoon	13 Insecticide storage	How many feet? <u>8'</u>
3 Watertight sewer lines	6 Seepage pit	9 Feedyard		

Direction from well? <u>North</u>	LITHOLOGIC LOG	FROM	TO	PLUGGING INTERVALS
		<u>22'</u>	<u>14'</u>	<u>1 Cu. ft. Sand + Gravel</u>
		<u>14'</u>	<u>0'</u>	<u>17 Cu. ft. Conc. Grout</u>
				<u>(Well in Concrete)</u>
				<u>Garage Floor.</u>

7 CONTRACTOR'S OR LANDOWNER'S CERTIFICATION: This water well was (1) constructed, (2) reconstructed, or (3) plugged under my jurisdiction and was completed on (mo/day/year) <u>7-2-94</u> and this record is true to the best of my knowledge and belief. Kansas Water Well Contractor's License No. <u>380</u> This Water Well Record was completed on (mo/day/yr) <u>7-2-94</u> under the business name of <u>Boyd Moore Const. Co.</u> by (signature) <u>Boyd A. Moore</u>
--