

1 LOCATION OF WATER WELL:	Fraction	Section Number	Township Number	Range Number
County: <u>Sedgwick</u>	<u>NE 1/4 NE 1/4 NE 1/4</u>	<u>16</u>	<u>T 28 S</u>	<u>R 1 EW</u>

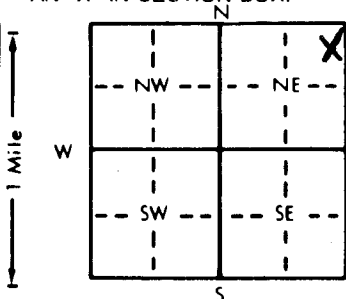
Distance and direction from nearest town or city street address of well if located within city?

1626 Selma Wichita, KS. 672162 WATER WELL OWNER: Clifford + Dorothy PorterRR#, St. Address, Box # : 1626 SelmaCity, State, ZIP Code : Wichita, KS. 67216

Board of Agriculture, Division of Water Resources

Application Number:

3 LOCATE WELL'S LOCATION WITH AN "X" IN SECTION BOX:

4 DEPTH OF COMPLETED WELL: 13 ft. ELEVATION:

Depth(s) Groundwater Encountered 1. ft. 2. ft. 3. ft.

WELL'S STATIC WATER LEVEL 12 ft. below land surface measured on mo/day/yr 9-4-94

Pump test data: Well water was ft. after hours pumping gpm

Est. Yield gpm: Well water was ft. after hours pumping gpm

Bore Hole Diameter in. to ft. and in. to ft.

WELL WATER TO BE USED AS: 5 Public water supply 8 Air conditioning 11 Injection well

1 Domestic 3 Feedlot 6 Oil field water supply 9 Dewatering 12 Other (Specify below)

2 Irrigation 4 Industrial 7 Lawn and garden only 10 Monitoring well

Was a chemical/bacteriological sample submitted to Department? Yes No; If yes, mo/day/yr sample was submitted

Water Well Disinfected? Yes No

5 TYPE OF BLANK CASING USED:

1 Steel 3 RMP (SR)
2 PVC 4 ABS5 Wrought iron 8 Concrete tile
6 Asbestos-Cement 9 Other (specify below)CASING JOINTS: Glued Clamped
Welded
ThreadedBlank casing diameter 5 in. to 13 ft. Dia. in. to ft. Dia. in. to ft.Casing height above land surface 3' below in. weight lbs./ft. Wall thickness or gauge No.

TYPE OF SCREEN OR PERFORATION MATERIAL:

1 Steel 3 Stainless steel 5 Fiberglass 8 RMP (SR) 11 Other (specify)
2 Brass 4 Galvanized steel 6 Concrete tile 9 ABS 12 None used (open hole)

SCREEN OR PERFORATION OPENINGS ARE:

1 Continuous slot 3 Mill slot 5 Gauzed wrapped 8 Saw cut 11 None (open hole)
2 Louvered shutter 4 Key punched 6 Wire wrapped 9 Drilled holes
7 Torch cut 10 Other (specify)

SCREEN-PERFORATED INTERVALS: From ft. to ft. From ft. to ft. From ft. to ft.

GRAVEL PACK INTERVALS: From ft. to ft. From ft. to ft. From ft. to ft.

6 GROUT MATERIAL:

1 Neat cement 2 Cement grout 3 Bentonite 4 OtherGrout Intervals: From 13' ft. to 3' ft. From ft. to ft. From ft. to ft.

What is the nearest source of possible contamination:

1 Septic tank 4 Lateral lines 7 Pit privy 10 Livestock pens 14 Abandoned water well
2 Sewer lines 5 Cess pool 8 Sewage lagoon 11 Fuel storage 15 Oil well/Gas well
3 Watertight sewer lines 6 Seepage pit 9 Feedyard 12 Fertilizer storage 16 Other (specify below)
13 Insecticide storage

Direction from well?

SouthHow many feet? @150'

FROM TO LITHOLOGIC LOG FROM TO PLUGGING INTERVALS

13'3'Cement Grout

(Note: Well plugged to floor (conc.) of Pit)

one of 3 wells
in the same pit7 CONTRACTOR'S OR LANDOWNER'S CERTIFICATION: This water well was (1) constructed, (2) reconstructed, or (3) plugged under my jurisdiction and was completed on (mo/day/year) 9-4-94 and this record is true to the best of my knowledge and belief. KansasWater Well Contractor's License No. 580 This Water Well Record was completed on (mo/day/yr) 9-4-94
under the business name of Boyd Moore Const. by (signature) Boyd Moore