


1 LOCATION OF WATER WELL:	Fraction <u>SE</u> $\frac{1}{4}$ <u>NW</u> $\frac{1}{4}$ <u>SW</u> $\frac{1}{4}$	Section Number <u>6</u>	Township Number T <u>28</u> S	Range Number R <u>1</u> EW
---------------------------	--	-------------------------	-------------------------------	----------------------------

Distance and direction from nearest town or city street address of well if located within city?

Located in Back yard of property, Next to back of House.

2 WATER WELL OWNER: <u>Traci Howell</u>	Board of Agriculture, Division of Water Resources
RR#, St. Address, Box # : <u>2763 S. Bennett, Wichita, KS, 67217</u>	Application Number:

3 LOCATE WELL'S LOCATION WITH AN "X" IN SECTION BOX:	4 DEPTH OF COMPLETED WELL: <u>77</u> ft. ELEVATION:
--	---

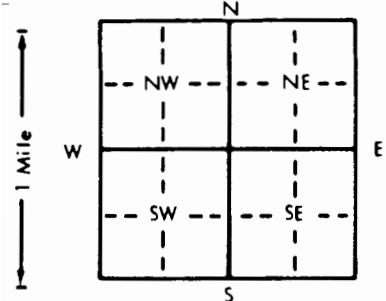

Depth(s) Groundwater Encountered 1. ft. 2. ft. 3. ft.

WELL'S STATIC WATER LEVEL 10 ft. below land surface measured on mo/day/yr

Pump test data: Well water was ft. after hours pumping gpm

Est. Yield gpm: Well water was ft. after hours pumping gpm

Bore Hole Diameter in. to ft., and in. to ft.

WELL WATER TO BE USED AS:

5 Public water supply	8 Air conditioning	11 Injection well
① Domestic	3 Feedlot	6 Oil field water supply
2 Irrigation	4 Industrial	7 Lawn and garden only
		10 Monitoring well
		12 Other (Specify below)

Was a chemical/bacteriological sample submitted to Department? Yes No ☒ If yes, mo/day/yr sample was submitted

Water Well Disinfected? Yes ☒ No

5 TYPE OF BLANK CASING USED:	5 Wrought iron	8 Concrete tile	CASING JOINTS: Glued Clamped
1 Steel	3 RMP (SR)	6 Asbestos-Cement	9 Other (specify below)
2 PVC	4 ABS	7 Fiberglass	
Blank casing diameter <u>1 1/4</u> in. to ft., Dia. in. to ft., Dia. in. to ft.			
Casing height above land surface <u>170</u> in., weight lbs./ft. Wall thickness or gauge No.			

TYPE OF SCREEN OR PERFORATION MATERIAL:	7 PVC	10 Asbestos-cement
1 Steel	3 Stainless steel	5 Fiberglass
2 Brass	4 Galvanized steel	6 Concrete tile
		8 RMP (SR)
		9 ABS
		11 Other (specify) <u>NA</u>
		12 None used (open hole)

SCREEN OR PERFORATION OPENINGS ARE:	5 Gauzed wrapped	8 Saw cut	11 None (open hole)
1 Continuous slot	3 Mill slot	6 Wire wrapped	9 Drilled holes
2 Louvered shutter	4 Key punched	7 Torch cut	10 Other (specify) <u>NA</u>

SCREEN-PERFORATED INTERVALS:	From <u>NA</u> ft. to <u>NA</u> ft.	From ft. to ft.	From ft. to ft.
GRAVEL PACK INTERVALS:	From ft. to ft.	From ft. to ft.	From ft. to ft.

6 GROUT MATERIAL:	① Neat cement	2 Cement grout	3 Bentonite	4 Other
Grout Intervals: From <u>17</u> ft. to <u>0</u> ft.	From ft. to ft.	From ft. to ft.	From ft. to ft.	From ft. to ft.

What is the nearest source of possible contamination:	10 Livestock pens	14 Abandoned water well
1 Septic tank	4 Lateral lines	7 Pit privy
2 Sewer lines	5 Cess pool	8 Sewage lagoon
③ Watertight sewer lines	6 Seepage pit	9 Feedyard
		11 Fuel storage
		12 Fertilizer storage
		13 Insecticide storage
		15 Oil well/Gas well
		16 Other (specify below)

Direction from well? South How many feet?

FROM	TO	LITHOLOGIC LOG	FROM	TO	PLUGGING INTERVALS
Top	Bottom	Removed Sand point and pipe. Fill hole full of cement, level at top.			
		Apprx. 15-17 ft. Deep.			
		packed hole to make sure			
		no voids or air pockets			
		could exist.			

7 CONTRACTOR'S OR LANDOWNER'S CERTIFICATION: This water well was (1) constructed, (2) reconstructed, or (3) <u>plugged under my jurisdiction</u> and was completed on (mo/day/year) <u>1/19/95</u> and this record is true to the best of my knowledge and belief. Kansas Water Well Contractor's License No. This Water Well Record was completed on (mo/day/yr) <u>1/19/95</u> under the business name of by (signature) <u>Tracy Howell</u>
--