


1 LOCATION OF WATER WELL: Fraction Section Number Township Number Range Number
 County: **SEDGWICK** **087** NE 1/4 NE 1/4 NE 1/4 4 T 28 S R 1 **EW**

Distance and direction from nearest town or city street address of well if located within city?
1535 E. PAWNEE WICHITA, KANSAS **Air Sparge # 11** **EAST**

2 WATER WELL OWNER: RR#, St. Address, Box # : **FINA OIL & COMPANY** Board of Agriculture, Division of Water Resources
 City, State, ZIP Code : **P.O. BOX 2159 DALLAS, TEXAS 75221** Application Number:

3 LOCATE WELL'S LOCATION WITH AN "X" IN SECTION BOX:

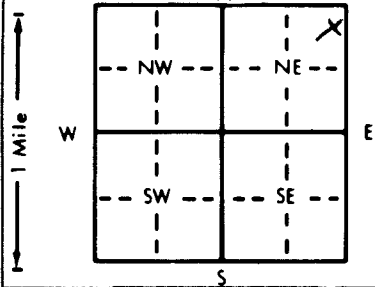

4 DEPTH OF COMPLETED WELL: **26** ft. ELEVATION:
 Depth(s) Groundwater Encountered 1. **17** ft. 2. ft. 3. ft.
 WELL'S STATIC WATER LEVEL **17** ft. below land surface measured on mo/day/yr
 Pump test data: Well water was ft. after hours pumping gpm
 Est. Yield gpm: Well water was ft. after hours pumping gpm
 Bore Hole Diameter **7 1/4** in. to **26** in. to in. to ft.
 WELL WATER TO BE USED AS: 5 Public water supply 8 Air conditioning 11 Injection well
 1 Domestic 3 Feedlot 6 Oil field water supply 9 Dewatering * Other (Specify below)
 2 Irrigation 4 Industrial 7 Lawn and garden only 10 Monitoring well **Sparg. Point**
 Was a chemical/bacteriological sample submitted to Department? Yes No; If yes, mo/day/yr sample was submitted
 Water Well Disinfected? Yes No

5 TYPE OF BLANK CASING USED: 5 Wrought iron 8 Concrete tile CASING JOINTS: Glued Clamped
 1 Steel 3 RMP (SR) 6 Asbestos-Cement 9 Other (specify below) Welded
 *PVC 4 ABS 7 Fiberglass Threaded.

Blank casing diameter **2 1/2** in. to **24** in. Dia. in. to in. Dia. in. to in. Dia. in. to in. Dia.
 Casing height above land surface **-3** in., weight **Sched 40** lbs./ft. Wall thickness or gauge No.

TYPE OF SCREEN OR PERFORATION MATERIAL: *PVC 10 Asbestos-cement
 1 Steel 3 Stainless steel 5 Fiberglass 8 RMP (SR) 11 Other (specify)
 2 Brass 4 Galvanized steel 6 Concrete tile 9 ABS 12 None used (open hole)

SCREEN OR PERFORATION OPENINGS ARE: 5 Gauzed wrapped 8 Saw cut 11 None (open hole)
 1 Continuous slot *Mill slot 6 Wire wrapped 9 Drilled holes
 2 Louvered shutter 4 Key punched 7 Torch cut 10 Other (specify)

SCREEN-PERFORATED INTERVALS: From **26** ft. to **24** ft., From ft. to ft.
 From ft. to ft., From ft. to ft.
 GRAVEL PACK INTERVALS: From **26** ft. to **22** ft., From ft. to ft.
 From ft. to ft., From ft. to ft.

6 GROUT MATERIAL: 1 Neat cement 2 Cement grout *Bentonite 4 Other
 Grout Intervals: From **18** ft. to **0.6** ft., From **22** ft. to **18** ft., From ft. to ft.

What is the nearest source of possible contamination:
 1 Septic tank 4 Lateral lines 7 Pit privy *Fuel storage 10 Livestock pens 14 Abandoned water well
 2 Sewer lines 5 Cess pool 8 Sewage lagoon 12 Fertilizer storage 15 Oil well/Gas well
 3 Watertight sewer lines 6 Seepage pit 9 Feedyard 13 Insecticide storage 16 Other (specify below)

Direction from well? **North** How many feet? **30**

FROM	TO	LITHOLOGIC LOG	FROM	TO	PLUGGING INTERVALS
0	6"	Concrete			
6"	3'	Top Soil			
3'	9'	Br. Clay			
9'	14'	Fine Sand			
14'	20'	Med Sand			
20'	26'	Med to Coarse Sand			

7 CONTRACTOR'S OR LANDOWNER'S CERTIFICATION: This water well was **1** constructed, (2) reconstructed, or (3) plugged under my jurisdiction and was completed on (mo/day/year) **1-18-95** and this record is true to the best of my knowledge and belief. Kansas Water Well Contractor's License No. **575** This Water Well Record was completed on (mo/day/yr) **2-7-95** under the business name of **KURTZ ENVIRONMENTAL SERVICE** by (signature) **[Signature]**