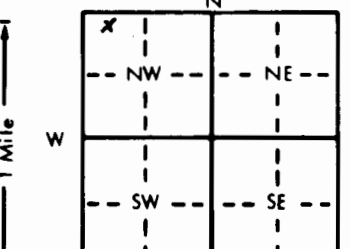


1) LOCATION OF WATER WELL: County: <u>SEDGWICK</u>		Fraction <u>NW 1/4 NW 1/4 NW 1/4</u>	Section Number <u>8</u>	Township Number T <u>28</u> S	Range Number R <u>1</u> <u>EW</u>
Distance and direction from nearest town or city street address of well if located within city? <u>1021 W. 31st SOUTH, WICHITA, KS 67217</u>					
2) WATER WELL OWNER: <u>COASTAL MART INC.</u> RR#, St. Address, Box #: <u>9 GREENWAY PLAZA</u> City, State, ZIP Code: <u>HOUSTON, TX 77046</u>					
Board of Agriculture, Division of Water Resources Application Number:					
3) LOCATE WELL'S LOCATION WITH AN "X" IN SECTION BOX: 		4) DEPTH OF COMPLETED WELL: <u>19</u> ft. ELEVATION: Depth(s) Groundwater Encountered 1. <u>14.0</u> ft. 2. ft. 3. ft. WELL'S STATIC WATER LEVEL <u>13.43</u> ft. below land surface measured on mo/day/yr <u>4/7/95</u> Pump test data: Well water was ft. after hours pumping gpm Est. Yield gpm: Well water was ft. after hours pumping gpm Bore Hole Diameter <u>8</u> in. to ft., and in. to ft. WELL WATER TO BE USED AS: 1 Domestic 3 Feedlot 6 Oil field water supply 9 Dewatering 12 Other (Specify below) 2 Irrigation 4 Industrial 7 Lawn and garden only <u>10 Monitoring well</u> Was a chemical/bacteriological sample submitted to Department? Yes No <u>X</u> ; If yes, mo/day/yr sample was submitted Water Well Disinfected? Yes No <u>X</u>			
5) TYPE OF BLANK CASING USED: 1 Steel 3 RMP (SR) 5 Wrought iron 8 Concrete tile CASING JOINTS: Glued Clamped <u>2 PVC</u> 4 ABS 6 Asbestos-Cement 9 Other (specify below) Welded Blank casing diameter <u>2</u> in. to ft., Dia. in. to ft., Dia. in. to ft., Dia. in. to ft. Casing height above land surface <u>FLUSH</u> in., weight <u>703</u> lbs./ft. Wall thickness or gauge No. <u>15.4</u> TYPE OF SCREEN OR PERFORATION MATERIAL: 1 Steel 3 Stainless steel 5 Fiberglass 8 RMP (SR) 10 Asbestos-cement 2 Brass 4 Galvanized steel 6 Concrete tile 9 ABS 11 Other (specify) SCREEN OR PERFORATION OPENINGS ARE: 1 Continuous slot 3 Mill slot 5 Gauzed wrapped 8 Saw cut 11 None (open hole) 2 Louvered shutter 4 Key punched 6 Wire wrapped 9 Drilled holes SCREEN-PERFORATED INTERVALS: From <u>1.9</u> ft. to <u>9</u> ft., From ft. to ft. GRAVEL PACK INTERVALS: From <u>1.9</u> ft. to <u>7</u> ft., From ft. to ft. From ft. to ft., From ft. to ft.					
6) GROUT MATERIAL: 1 Neat cement 2 Cement grout 3 Bentonite 4 Other Grout Intervals: From <u>7</u> ft. to <u>1</u> ft., From ft. to ft., From ft. to ft. What is the nearest source of possible contamination: 1 Septic tank 4 Lateral lines 7 Pit privy 10 Livestock pens 14 Abandoned water well 2 Sewer lines 5 Cess pool 8 Sewage lagoon 11 Fuel storage 15 Oil well/Gas well 3 Watertight sewer lines 6 Seepage pit 9 Feedyard 12 Fertilizer storage 16 Other (specify below) 13 Insecticide storage Direction from well? <u>IN UST BASIN</u> How many feet? <u>NA</u>					
FROM TO LITHOLOGIC LOG		FROM TO PLUGGING INTERVALS			
1.0	4.0	CLAY, SILT, GRAVEL			
4.0	8.0	CLAY, SILT			
8.0	13.5	SAND			
13.5	19.0	SAND, GRAVEL			
7) CONTRACTOR'S OR LANDOWNER'S CERTIFICATION: This water well was <u>(1) constructed</u> , (2) reconstructed, or (3) plugged under my jurisdiction and was completed on (mo/day/year) <u>4/7/95</u> and this record is true to the best of my knowledge and belief. Kansas Water Well Contractor's License No. <u>531</u> This Water Well Record was completed on (mo/day/yr) <u>4/11/95</u> under the business name of <u>GSI</u> by (signature) <u>Steve Nudler</u>					