

WATER WELL RECORD Form WWC-5


Original Record Correction Change in Well Use

Division of Water Resources App. No.

Well ID

1 LOCATION OF WATER WELL: County: Fraction Section Number Township Number Range Number

2 WELL OWNER: Last Name: Business: Address: City: State: ZIP: Street or Rural Address where well is located

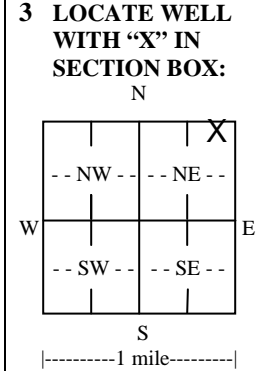

4 DEPTH OF COMPLETED WELL: Depth(s) Groundwater Encountered: WELL'S STATIC WATER LEVEL: Pump test data: Estimated Yield: Bore Hole Diameter:

5 Latitude: Longitude: Datum: Source for Latitude/Longitude: 6 Elevation: Source:

7 WELL WATER TO BE USED AS: 1. Domestic: 2. Irrigation: 3. Feedlot: 4. Industrial: 5. Public Water Supply: 6. Dewatering: 7. Aquifer Recharge: 8. Monitoring: 9. Environmental Remediation: 10. Oil Field Water Supply: 11. Test Hole: 12. Geothermal: 13. Other

Was a chemical/bacteriological sample submitted to KDHE? Water well disinfected?

8 TYPE OF CASING USED: CASING JOINTS: TYPE OF SCREEN OR PERFORATION MATERIAL: SCREEN OR PERFORATION OPENINGS ARE: SCREEN-PERFORATED INTERVALS: GRAVEL PACK INTERVALS:

9 GROUT MATERIAL: Grout Intervals: Nearest source of possible contamination: Direction from well? Distance from well?

Table with 6 columns: 10 FROM, TO, LITHOLOGIC LOG, FROM, TO, LITHO. LOG (cont.) or PLUGGING INTERVALS. Includes a Notes section.

11 CONTRACTOR'S OR LANDOWNER'S CERTIFICATION: This water well was constructed, reconstructed, or plugged under my jurisdiction and was completed on (mo-day-year) and this record is true to the best of my knowledge and belief.



ENVIRONMENTAL WORKS
OUR EXPERTISE. YOUR SUCCESS.

ENVIRONMENTAL WORKS INC.
1731 Locust Street
Kansas City, Missouri 64108
Phone: 816-285-8410 Fax: 816-285-8409
www.environmentalworks.com

Boring Number: MW-2

Project : Merle Kelly Ford
Location : 3501 S. Santa Fe Ave.
City/State : Chanute, Kansas
Drilled By : Sara Rick
Logged By : Carmelo Blazekovic
Drilling Method: 7822DT Geoprobe
Sampling Method : Dual Tube 5' Continuous Sampler

Project Number : 210061
Date Drilled : 3/15/2021
Inspected by : Carmelo Blazekovic
Drafted by : Jordan Benningfield
Boring Depth : 7.0 ft bgs
Water Level - Static : ft. BGS

DEPTH BELOW	LITHOLOGY		SAMPLING AND WELL DATA					
	LITHOLOGIC SYMBOL	GEOLOGIC DESCRIPTION OF SOIL AND ROCK STRATA	Well Construct.	PID Value	PID (ppm)	Recovery	Sample Interval	Remarks
0		GRAVEL		0.0				1615: Begin boring
0		SILTY CLAY, light yellowish brown (10YR 6/4), low plasticity, moist, medium consistency		0.0				
1		SILTY CLAY, very dark gray, (10YR 7/6), high plasticity, moist, medium consistency		0.0				
2		SILTY CLAY, yellow, (10YR 7/6), high plasticity, moist, soft		0.0		3.2 / 5.0	MW-2 2.0-3.0' 1430	Sampled for VOCs, RCRA Metals, KS MRH/HRH, KS TPH LRH
3		SILTY CLAY, yellow, (10YR 7/6), high plasticity, moist, soft		0.0				
4		SILTY CLAY, yellow, (10YR 7/6), high plasticity, moist, soft		0.0				
5		SILTY CLAY, yellow, (10YR 7/6), high plasticity, moist, soft		0.0				
6		SILTY CLAY, yellow, (10YR 7/6), high plasticity, moist, soft		0.0		2.0 / 2.0		
7		CLAYEY SILT, (10YR 7/6), low plasticity, moist, soft, with some fine grained sand		0.0				DPT refusal on sandstone at 7.0 ft bgs
7		Refusal at 7.0 ft bgs due to sandstone						

Notes : Located approximately 15 feet south of truck repair shop near concrete drive.

Drilled By : Sara Rick
 Logged By : Carmelo Blazekovic
 Drilling Method: 7822DT Geoprobe
 Sampling Method : Dual Tube 5' Continuous Sampler

Drafted by : Jordan Benningfield
 Boring Depth : 7.0 ft bgs
 Water Level - Static : ft. BGS

DEPTH BELOW	LITHOLOGY		SAMPLING AND WELL DATA					
	LITHOLOGIC SYMBOL	GEOLOGIC DESCRIPTION OF SOIL AND ROCK STRATA	Well Construct.	PID Value	PID (ppm)	Recovery	Sample Interval	Remarks
					0 10			
						5.0 /	5.0	
						5.0 /	5.0	

Notes : Located approximately 15 feet south of truck repair shop near concrete drive.

Drilled By : Sara Rick
 Logged By : Carmelo Blazekovic
 Drilling Method: 7822DT Geoprobe
 Sampling Method : Dual Tube 5' Continuous Sampler

Drafted by : Jordan Benningfield
 Boring Depth : 7.0 ft bgs
 Water Level - Static : ft. BGS

DEPTH BELOW	LITHOLOGY		SAMPLING AND WELL DATA					
	LITHOLOGIC SYMBOL	GEOLOGIC DESCRIPTION OF SOIL AND ROCK STRATA	Well Construct.	PID Value	PID (ppm)	Recovery	Sample Interval	Remarks

						5.0 /		
						5.0		
						—		1010: Stop
						—		
						5.0 /		

Notes : Located approximately 15 feet south of truck repair shop near concrete drive.

