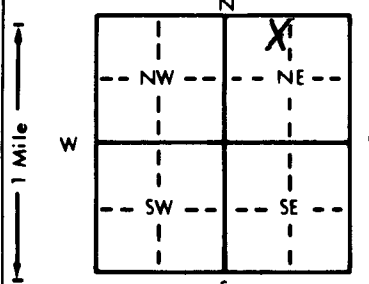


1 LOCATION OF WATER WELL: County: <u>Seg</u>	Fraction <u>NE</u> $\frac{1}{4}$ <u>NW</u> $\frac{1}{4}$ <u>NE</u> $\frac{1}{4}$	Section Number <u>34</u>	Township Number T <u>28</u> S	Range Number R <u>2</u> <u>W</u>
---	---	-----------------------------	----------------------------------	-------------------------------------

Distance and direction from nearest town or city street address of well if located within city?

2 WATER WELL OWNER: RR#, St. Address, Box # : <u>Rob Hull</u> <u>2200 S. Rock Rd #102</u> City, State, ZIP Code : <u>Wichita, KS 67207</u>	Board of Agriculture, Division of Water Resources Application Number:
---	--

3 LOCATE WELL'S LOCATION WITH AN "X" IN SECTION BOX: 	4 DEPTH OF COMPLETED WELL: <u>70'</u> ft. ELEVATION: Depth(s) Groundwater Encountered 1. <u>50</u> ft. 2. ft. 3. ft. WELL'S STATIC WATER LEVEL <u>22</u> ft. below land surface measured on mo/day/yr <u>7/12/95</u> Pump test data: Well water was ft. after hours pumping gpm Est. Yield <u>40</u> gpm: Well water was ft. after hours pumping gpm Bore Hole Diameter <u>1.0</u> in. to ft., and in. to ft. WELL WATER TO BE USED AS: 1 Domestic 3 Feedlot 6 Oil field water supply 9 Dewatering 12 Other (Specify below) 2 Irrigation 4 Industrial 7 Lawn and garden only 10 Monitoring well Was a chemical/bacteriological sample submitted to Department? Yes No ☒ If yes, mo/day/yr sample was submitted
--	---

5 TYPE OF BLANK CASING USED: 1 Steel 3 RMP (SR) 2 <u>PVC</u> 4 ABS Blank casing diameter <u>5</u> in. to ft., Dia. in. to ft., Dia. in. to ft. Casing height above land surface <u>12</u> in., weight <u>160</u> lbs./ft. Wall thickness or gauge No. TYPE OF SCREEN OR PERFORATION MATERIAL: 1 Steel 3 Stainless steel 5 Fiberglass 7 <u>PVC</u> 10 Asbestos-cement 2 Brass 4 Galvanized steel 6 Concrete tile 8 RMP (SR) 11 Other (specify) 12 None used (open hole) SCREEN OR PERFORATION OPENINGS ARE: 1 Continuous slot 3 <u>Mill slot</u> 5 Gauzed wrapped 8 Saw cut 11 None (open hole) 2 Louvered shutter 4 Key punched 6 Wire wrapped 9 Drilled holes 7 Torch cut 10 Other (specify) SCREEN-PERFORATED INTERVALS: From <u>50</u> ft. to <u>70</u> ft., From ft. to ft. GRAVEL PACK INTERVALS: From <u>20</u> ft. to <u>70</u> ft., From ft. to ft.	CASING JOINTS: Glued ☒ Clamped Welded Threaded
---	--

6 GROUT MATERIAL: 1 Neat cement 2 Cement grout 3 <u>Bentonite</u> 4 Other Grout Intervals: From <u>3</u> ft. to <u>20</u> ft., From ft. to ft. What is the nearest source of possible contamination: 1 Septic tank 4 Lateral lines 7 Pit privy 10 Livestock pens 14 Abandoned water well 2 Sewer lines 5 Cess pool 8 <u>Sewage lagoon</u> 11 Fuel storage 15 Oil well/Gas well 3 Watertight sewer lines 6 Seepage pit 9 Feedyard 12 Fertilizer storage 16 Other (specify below) 13 Insecticide storage Direction from well? <u>downslope</u> How many feet? <u>50+</u>

FROM	TO	LITHOLOGIC LOG	FROM	TO	PLUGGING INTERVALS
0	2	dirt			
2	6	brown clay			
6	20	red clay			
20	45	yellow clay			
45	70	shale			

7 CONTRACTOR'S OR LANDOWNER'S CERTIFICATION: This water well was (1) constructed, (2) reconstructed, or (3) plugged under my jurisdiction and was completed on (mo/day/year) <u>7/12/95</u> and this record is true to the best of my knowledge and belief. Kansas Water Well Contractor's License No. <u>493</u> This Water Well Record was completed on (mo/day/yr) <u>7/12/95</u> under the business name of <u>Reisner Well Drilling</u> by (signature) <u>Derek Reisner</u>
--