


1 LOCATION OF WATER WELL: Fraction NE 1/4 NW 1/4 SE 1/4 Section Number 28 Township Number T 28 S Range Number R 2 E
 Distance and direction from nearest town or city street address of well if located within city?
1330 E 59th St

2 WATER WELL OWNER: Mrs U Banks
 RR#, St. Address, Box # : 1330 E 59th St
 City, State, ZIP Code : Wichita, KS 67216
 Board of Agriculture, Division of Water Resources Application Number: none

3 LOCATE WELL'S LOCATION WITH AN "X" IN SECTION BOX: 4 DEPTH OF COMPLETED WELL: 40 ft. ELEVATION: 1300

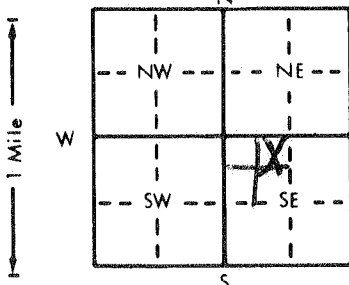

Depth(s) Groundwater Encountered 1. 20 ft. 2. 20 ft. 3. 20 ft.
 WELL'S STATIC WATER LEVEL 20 ft. below land surface measured on mo/day/yr 8-30-96




WELL WATER TO BE USED AS: 5 Public water supply 8 Air conditioning 11 Injection well

1 Domestic 3 Feedlot 6 Oil field water supply 9 Dewatering 12 Other (Specify below)

2 Irrigation 4 Industrial 7 Lawn and garden only 10 Monitoring well

Was a chemical/bacteriological sample submitted to Department? Yes X No X If yes, mo/day/yr sample was submitted

Water Well Disinfected? Yes X No X

5 TYPE OF BLANK CASING USED: 5 Wrought iron 8 Concrete tile CASING JOINTS: Glued X Clamped X

1 Steel 3 RMP (SR) 6 Asbestos-Cement 9 Other (specify below) Welded X

2 PVC 4 ABS 7 Fiberglass Threaded X

Blank casing diameter 5 in. to 30 ft., Dia 5 in. to 30 ft., Dia 5 in. to 30 ft.

Casing height above land surface 12 in., weight 12 lbs./ft. Wall thickness or gauge No. 160

TYPE OF SCREEN OR PERFORATION MATERIAL: 17 PVC 10 Asbestos-cement

1 Steel 3 Stainless steel 5 Fiberglass 8 RMP (SR) 11 Other (specify)

2 Brass 4 Galvanized steel 6 Concrete tile 9 ABS 12 None used (open hole)

SCREEN OR PERFORATION OPENINGS ARE: 5 Gauzed wrapped 8 Saw cut 11 None (open hole)

1 Continuous slot 3 Mill slot 6 Wire wrapped 9 Drilled holes

2 Louvered shutter 4 Key punched 7 Torch cut 10 Other (specify)

SCREEN-PERFORATED INTERVALS: From 30 ft. to 40 ft., From 30 ft. to 40 ft., From 30 ft. to 40 ft.





What is the nearest source of possible contamination: 10 Livestock pens 14 Abandoned water well

1 Septic tank 4 Lateral lines 7 Pit privy 11 Fuel storage 15 Oil well/Gas well

2 Sewer lines 5 Cess pool 8 Sewage lagoon 12 Fertilizer storage 16 Other (specify below)

3 Watertight sewer lines 6 Septage pit 9 Feedyard 13 Insecticide storage

Direction from well? East How many feet? 70

FROM TO LITHOLOGIC LOG FROM TO PLUGGING INTERVALS

0 9 Top Soil 0 9

9 25 Fine Tan Sand 9 25

25 40 Coarse Tan Sand 25 40

7 CONTRACTOR'S OR LANDOWNER'S CERTIFICATION: This water well was (1) constructed, (2) reconstructed, or (3) plugged under my jurisdiction and was completed on (mo/day/year) 8-30-96 and this record is true to the best of my knowledge and belief. Kansas

Water Well Contractor's License No. 477 This Water Well Record was completed on (mo/day/yr) 8-30-96

under the business name of Bearden Pump & Well Serv. (signature) David Beek