

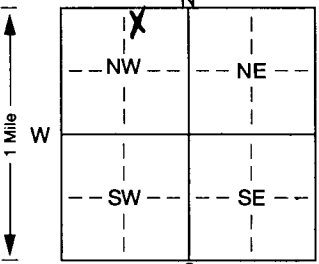
007176

WATER WELL RECORD

Form WWC-5

KSA 82a-1212 ID No.

00300175

1 LOCATION OF WATER WELL: Fraction <u>NW 1/4 NE 1/4 NW 1/4</u> Section Number <u>5</u> Township Number <u>T 28 S</u> Range Number <u>R 2 E</u>	
County: <u>Sedgwick</u> Distance and direction from nearest town or city street address of well if located within city? <u>8401 E Oak Knoll</u>	
2 WATER WELL OWNER: <u>Beran Properties</u> RR#, St. Address, Box #: <u>8401 E Oak Knoll</u> City, State, ZIP Code: <u>Wichita KS 67207</u> Board of Agriculture, Division of Water Resources Application Number: <u>1389.71 TCC</u>	
3 LOCATE WELL'S LOCATION WITH AN "X" IN SECTION BOX: 	4 DEPTH OF COMPLETED WELL: <u>30</u> ft. ELEVATION: <u>1389.71 TCC</u> Depth(s) Groundwater Encountered 1. <u>25</u> ft. 2. <u>30</u> ft. 3. <u>30</u> ft. chemical/bacteriological sample submitted to Department? Yes <u>No</u> ; If yes, mo/day/yr sample was submitted <u>No</u> Water Well Disinfected? Yes <u>No</u>
5 TYPE OF BLANK CASING USED: 1 Steel 3 RMP (SR) 6 Asbestos-Cement 9 Other (specify below) Welded <u>Flush</u> <u>2 PVC</u> 4 ABS 7 Fiberglass <u>Threaded</u> Blank casing diameter <u>2</u> in. to <u>19</u> ft.OPENINGS ARE: 1 Continuous slot 3 Mill slot 5 Gauzed wrapped 8 Saw cut 11 None (open hole) 2 Louvered shutter 4 Key punched 6 Wire wrapped 9 Drilled holes 7 Torch cut 10 Other (specify) <u>3</u> ft. SCREEN-PERFORATED INTERVALS: From <u>19</u> ft. to <u>29</u> ft., From <u>29</u> ft. to <u>29</u> ft. GRAVEL PACK INTERVALS: From <u>17</u> ft. to <u>29</u> ft., From <u>29</u> ft. to <u>29</u> ft.	

FROM TO LITHOLOGIC LOG	FROM TO PLUGGING INTERVALS
0 3 Clay & gravel	
3 7.5 Clay	
7.5 13.5 Shale: highly weathered, clayey	
13.5 18.5 Shale: silty	
18.5 30 Shale, clayey	
7 CONTRACTOR'S OR LANDOWNER'S CERTIFICATION: This water well was (1) constructed, (2) reconstructed, or (3) plugged under my jurisdiction and was completed on (mo/day/year) <u>11/27/00</u> and this record is true to the best of my knowledge and belief. Kansas Water Well Contractor's Licence No. <u>531</u> This Water Well Record was completed on (mo/day/yr) <u>12/6/00</u> under the business name of <u>Geotechnical Services, Inc.</u> by (signature) <u>Allison M. Smith</u>	