

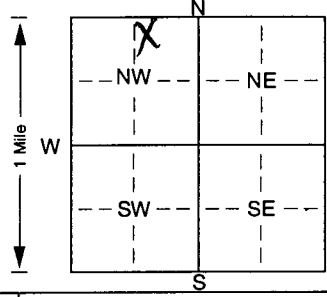
007176

WATER WELL RECORD

Form WWC-5

KSA 82a-1212 ID No.

00300113

1 LOCATION OF WATER WELL:		Fraction	Section Number	Township Number	Range Number
County: <u>Sedgewick</u>		<u>NW 1/4 NE 1/4 NW 1/4</u>	<u>5</u>	<u>T 28 S</u>	<u>R 2 E</u>
Distance and direction from nearest town or city street address of well if located within city? <u>8401 E Oak Knoll</u>					
2 WATER WELL OWNER:					
RR#, St. Address, Box # : <u>Beran Properties</u>					
City, State, ZIP Code : <u>Wichita KS 67207</u>					
Board of Agriculture, Division of Water Resources Application Number: <u>1389.83 TC</u>					
3 LOCATE WELL'S LOCATION WITH AN "X" IN SECTION BOX:		4 DEPTH OF COMPLETED WELL: <u>29</u> ft. ELEVATION: <u>1389.83 TC</u>			
		Depth(s) Groundwater Encountered 1. <u>18</u> ft. 2. .ft. 3. .ft.			
		WELL'S STATIC WATER LEVEL .ft. below land surface measured on mo/day/yr .ft.			
		Pump test data: Well water was .ft. after .hours pumping .gpm			
		Est. Yield .gpm Well water was .ft. after .hours pumping .gpm			
		Bore Hole Diameter. <u>8.5</u> in. to <u>29</u> .ft., and. .in. to .ft.			
		WELL WATER TO BE USED AS: 5 Public water supply 8 Air conditioning 11 Injection well			
		1 Domestic 3 Feedlot 6 Oil field water supply 9 Dewatering 12 Other (Specify below)			
		2 Irrigation 4 Industrial 7 Domestic (lawn & garden) <u>10 Monitoring well mw-9</u>			
		Was a chemical/bacteriological sample submitted to Department? Yes. . No. <u>X</u> ; If yes, mo/day/yr sample was submitted			
		Water Well Disinfected? Yes . No. <u>X</u>			
5 TYPE OF BLANK CASING USED:					
1 Steel 3 RMP (SR) 5 Wrought iron 8 Concrete tile CASING JOINTS: Glued. . Clamped. .					
2 PVC 4 ABS 6 Asbestos-Cement 9 Other (specify below) Welded. .					
7 Fiberglass . Threaded. .					
Blank casing diameter . <u>2</u> in. to <u>13</u> .ft., Dia .in. to .ft., Dia .in. to .ft.					
Casing height above land surface. .in., weight . <u>703</u> lbs./ft. Wall thickness or gauge No. <u>Sch 40</u>					
TYPE OF SCREEN OR PERFORATION MATERIAL:					
1 Steel 3 Stainless steel 5 Fiberglass 7 PVC 10 Asbestos-cement					
2 Brass 4 Galvanized steel 6 Concrete tile 8 RMP (SR) 11 Other (specify) .					
9 ABS 12 None used (open hole)					
SCREEN OR PERFORATION OPENINGS ARE:					
1 Continuous slot 3 Mill slot 5 Gauzed wrapped 8 Saw cut 11 None (open hole)					
2 Louvered shutter 4 Key punched 6 Wire wrapped 9 Drilled holes					
7 Torch cut 10 Other (specify) .ft.					
SCREEN-PERFORATED INTERVALS: From. <u>13</u> ft. to <u>28</u> ft., From .ft. to .ft.					
GRAVEL PACK INTERVALS: From. <u>11</u> ft. to <u>28</u> ft., From .ft. to .ft.					
28					
FROM TO LITHOLOGIC LOG FROM TO PLUGGING INTERVALS					
0	0.5	Gravel			
0.5	4	Clay, silty			
4	8	Shale, clayey, silty			
8	13	Shale			
13	29	Shale, clayey, sandy layers			
7 CONTRACTOR'S OR LANDOWNER'S CERTIFICATION: This water well was <u>(4) constructed</u> , <u>(2) reconstructed</u> , or <u>(3) plugged</u> under my jurisdiction and was completed on (mo/day/year) <u>11/27/00</u> and this record is true to the best of my knowledge and belief. Kansas Water Well Contractor's Licence No. <u>331</u> This Water Well Record was completed on (mo/day/yr) <u>12/16/00</u> under the business name of <u>Geotechnical Services, Inc</u> by (signature) <u>Allison M. Smith</u>					
INSTRUCTIONS: Use typewriter or ball point pen. PLEASE PRESS FIRMLY and PRINT clearly. Please fill in blanks, underline or circle the correct answers. Send top three copies to Kansas Department of Health and Environment, Bureau of Water, Topeka, Kansas 66620-0001. Telephone 785-296-5524. Send one to WATER WELL OWNER and retain one for your records. Fee of \$5.00 for each constructed well.					