


SW of Building 968, McConnell Air Force Base – Wichita

Board of Agriculture, Division of Water Resources
Application Number:

4	DEPTH OF COMPLETED WELL	15	ft	ELEVATION:
---	-------------------------	----	----	------------

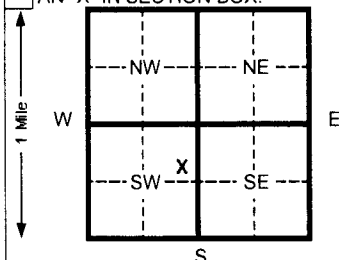

2 Irrigation 4 Industrial 7 Lawn and garden (domestic) **10 Monitoring well** _____

Was a chemical/bacteriological sample submitted to Department? Yes _____ No **X** If yes, mo/day/yr sample was submitted _____
Water Well Disinfected? Yes _____ No **X**

Threaded	Flush
----------	-------

From	ft. to	ft. From	ft. to	ft.

--	--	--	--	--	--	--

INSTRUCTIONS: Please fill in blanks and circle the correct answers. Send three copies to Kansas Department of Health and Environment, Bureau of Water, 1000 S W Jackson St., Ste. 420, Topeka, Kansas 66612-1367. Telephone: 913-296-5545. Send one to WATER WELL OWNER and retain one for your records.