GSI Job No. 097364 **MFT3-MW16**

WATER WELL RECORD Form WWC-5 KSA 82a-1212 ID No. _____

1 LOCATION OF WATER WELL:	Fraction	Section Number	Township Number	Range Number
County: **Sedgwick**	**W** 1/2 **SW** ¼ **NE** ¼	**18**	T **28** S	R **2** E

Distance and direction from nearest town or city street address of well if located within city?
Site FT07, McConnell Air Force Base – Wichita

2 WATER WELL OWNER: **22nd CES CEVQ US Air Force**
RR#, St. Address, Box # : **53000 Hutchinson St., Ste. 109 MAFB** Board of Agriculture, Division of Water Resources
City, State, ZIP Code : **Wichita, KS 67221** Application Number:

3 LOCATE WELL'S LOCATON WITH AN "X" IN SECTION BOX:

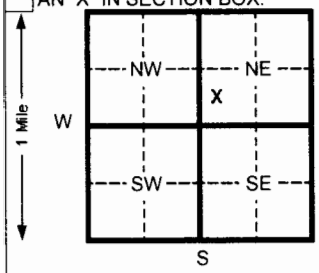

4 DEPTH OF COMPLETED WELL **23** ft. ELEVATION:
Depth(s) Groundwater Encountered 1 _____ ft. 2 _____ ft. 3 _____ ft.
WELL'S STATIC WATER LEVEL _____ ft. below land surface measured on mo/day/yr _____
Pump test data: Well water was _____ ft. after _____ hours pumping _____ gpm
Est. Yield _____ gpm: Well water was _____ ft. after _____ hours pumping _____ gpm
Bore Hole Diameter **8.25** in. to **24** ft. and _____ in. to _____ ft.
WELL WATER TO BE USED AS: 5 Public water supply 8 Air conditioning 11 Injection well
1 Domestic 3 Feed lot 6 Oil field water supply 9 Dewatering 12 Other (Specify below)
2 Irrigation 4 Industrial 7 Lawn and garden (domestic) **10 Monitoring well**
Was a chemical/bacteriological sample submitted to Department? Yes _____ No **X** If yes, mo/day/yr sample was submitted
Water Well Disinfected? Yes _____ No **X**

5 TYPE OF BLANK CASING USED: 5 Wrought Iron 8 Concrete tile CASING JOINTS: Glued _____ Clamped _____
1 Steel 3 RMP (SR) 6 Asbestos-Cement 9 Other (specify below) Welded
2 PVC 4 ABS 7 Fiberglass Threaded **Flush**
Blank casing diameter **2** in. to **13** ft., Dia _____ in. to _____ ft., Dia _____ in. to _____ ft.
Casing height above land surface **>24** in., weight **0.703** lbs./ft. Wall thickness or gauge No. **SCH. 40**
TYPE OF SCREEN OR PERFORATION MATERIAL: **7 PVC** 10 Asbestos-cement
1 Steel 3 Stainless steel 5 Fiberglass 8 RMP (SR) 11 Other (specify) _____
2 Brass 4 Galvanized steel 6 Concrete tile 9 ABS 12 None used (open hole)
SCREEN OR PERFORATION OPENINGS ARE: 5 Gauzed wrapped 8 Saw cut 11 None (open hole)
1 Continuous slot **3 Mill slot** 6 Wire wrapped 9 Drilled holes
2 Louvered shutter 4 Key punched 7 Torch cut 10 Other (specify) _____
SCREEN-PERFORATED INTERVALS: From **13** ft. to **23** ft. From _____ ft. to _____ ft.
From _____ ft. to _____ ft. From _____ ft. to _____ ft.
GRAVEL PACK INTERVALS: From **11** ft. to **24** ft. From _____ ft. to _____ ft.
From _____ ft. to _____ ft. From _____ ft. to _____ ft.

6 GROUT MATERIAL: 1 Neat cement 2 Cement grout **3 Bentonite** **4 Other** **High-solids sodium bentonite grout**
Grout Intervals From **11** ft. to **8** ft. From **8** ft. to **1** ft. From _____ ft. to _____ ft.
What is the nearest source of possible contamination: 10 Livestock pens 14 Abandoned water well
1 Septic tank 4 Lateral lines 7 Pit privy 11 Fuel storage 15 Oil well/ Gas well
2 Sewer lines 5 Cess pool 8 Sewage lagoon 12 Fertilizer storage 16 Other (specify below)
3 Watertight sewer lines 6 Seepage pit 9 Feedyard 13 Insecticide storage
Direction from well? How many feet?

FROM	TO	CODE	LITHOLOGIC LOG	FROM	TO	PLUGGING INTERVALS
0.0	0.5		**Topsoil**			
0.5	18.0		**Lean Clay, light brown to green gray, some sand and gravel, some gypsum**			
18.0	20.0		**Silt, light gray**			
20.0	24.0		**Lean Clay, red light brown**			

7 CONTRACTOR'S OR LANDOWNER'S CERTIFICATION: This water well was **(1) constructed**, (2) reconstructed, or (3) plugged under my jurisdiction and was completed on (mo/day/yr) **11/21/09** and this record is true to the best of my knowledge and belief. Kansas Water Well Contractor's License No. **531** This Water Well Record was completed on (mo/day/yr) **12/14/09**
under the business name of **Geotechnical Services Inc.** by (signature)

INSTRUCTIONS:. Please fill in blanks and circle the correct answers. Send three copies to Kansas Department of Health and Environment, Bureau of Water, 1000 S W Jackson St., Ste. 420, Topeka, Kansas 66612-1367. Telephone: 913-296-5545. Send one to WATER WELL OWNER and retain one for your records.

OFFICE USE ONLY T R SEC

White CopyWhite Copy Form provided by Forms-On-A-Disk, Inc. · Dallas, Texas · (214) 340-9429