USE TYPEWRITER OR BALL POINT PEN-PRESS FIRMLY, PRINT CLEARLY.

WATER WELL RECORD
KSA 82a-1201-1215

Kansas Department of Health and Environment-Division of Environment
(Water well Contractors)
Topeka, Kansas 66620

1. Location of well:	County: Sedgwick	Fraction: NE 1/4 SW 1/4 NE 1/4	Section number: 34	Township number: T 28 S	Range number: R 2 (E) W

2. Distance and direction from nearest town or city: 3 Mile East of Derby Kan
Street address of well location if in city: Lot 2

3. Owner of well: J.W. Ferguson
R.R. or street: 6126 South Seneca
City, state, zip code: Wichita Kan 67217

4. Locate with "X" in section below:

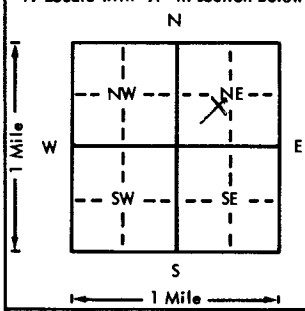

Sketch map:

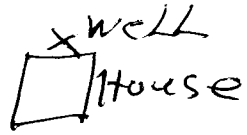

Slop
Septic Line

6. Bore hole dia. 8 in. Completion date 4/10/79
Well depth 100 ft.

7. X Cable tool __ Rotary __ Driven __ Dug
__ Hollow rod __ Jetted __ Bored __ Reverse rotary

8. Use: X Domestic __ Public supply __ Industry
__ Irrigation __ Air conditioning __ Stock
__ Lawn __ Oil field water __ Other

9. Casing: Material PVC
Threaded __ Welded __
RMP __ PVC X
Dia. 5 in. to 100 ft. depth
Dia. __ in. to __ ft. depth
Height: Above or below Surface 18 in.
Weight 100 lbs./ft.
Wall Thickness: inches or gage No. 175

10. Screen: Manufacturer's name Sun Flower
Type 100 Dia. 5
Slot/gauze 1/16 Length 20
Set between 70 ft. and 90 ft.
__ ft. and __ ft.
Gravel pack? Yes Size range of material 3/8

11. Static water level: mo./day/yr.
50 ft. below land surface Date 4/10/79

12. Pumping level below land surface: Bailling
60 ft. after 1 hrs. pumping __ g.p.m.
__ ft. after __ hrs. pumping 20 g.p.m.
Estimated maximum yield 20 g.p.m.

13. Water sample submitted: mo./day/yr.
__ Yes X No Date

14. Well head completion:
__ Pitless adapter __ Inches above grade

15. Well grouted? Yes
With: __ Neat cement __ Bentonite X Concrete
Depth: From 0 ft. to 10 ft.

16. Nearest source of possible contamination:
ft. 70 Direction S W Type Septic Line
Well disinfected upon completion? Yes Yes __ No

17. Pump: X Not installed
Manufacturer's name
Model number HP Volts
Length of drop pipe ft. capacity g.p.m.
Type:
__ Submersible __ Turbine
__ Jet __ Reciprocating
__ Centrifugal __ Other

5. Type and color of material	From	To
Soil	0	4
Clay	4	20
Rock	20	25
Clay-gray	25	45
Shale	45	55
Limestone	55	70
Water Lime	70	90
Shale	90	100

(Use a second sheet if needed)

18. Elevation:

Topography:
__ Hill
__ Slope
X Upland
__ Valley

19. Remarks:

20. Water well contractor's certification:
This well was drilled under my jurisdiction and this report is true to the best of my knowledge and belief.
Winter Well Drilling
Business name License No. 25
Address [redacted]
Signed [redacted] Date 3/14/85
Authorized representative

T 28 S R 2 (E) W Sec 34 1/4 NE 1/4 SW 1/4 NE 1/4

Forward the white, blue and pink copies to the Department of Health and Environment

Form WWC-5