


2 WATER WELL OWNER: 22nd CES CEVQ US Air Force

Board of Agriculture, Division of Water Resources
Application Number:

4	DEPTH OF COMPLETED WELL	15.9	ft. ELEVATION:	1385.52 (TOC)
---	-------------------------	------	----------------	---------------

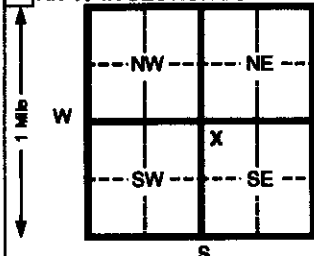

Depth(s) Groundwater Encountered 1 18 ft. 2 4 ft. 3 _____ ft.

WELL'S STATIC WATER LEVEL _____ ft. below land surface measured on mo/day/yr _____

Pump test data: Well water was _____ ft. after _____ hours pumping _____ gpm

Est. Yield _____ gpm: Well water was _____ ft. after _____ hours pumping _____ gpm

Bore Hole Diameter 7 in. to 16 ft. and _____ in. to _____ ft.

WELL WATER TO BE USED AS:

1 Domestic	3 Feed lot	6 Oil field water supply	8 Air conditioning	11 Injection well
2 Irrigation	4 Industrial	7 Lawn and garden (domestic)	9 Dewatering	12 Other (Specify below)
			10 Monitoring well	

Was a chemical/bacteriological sample submitted to Department? Yes _____ No ☒ If yes, mo/day/yr sample was submitted _____

Water Well Disinfected? Yes _____ No ☒

5	Wrought iron	8	Concrete tile	CASING JOINTS: Glued	Clamped
---	--------------	---	---------------	----------------------	---------

1 Steel	3 RMP (SR)
2 PVC	4 ABS

8 Asbestos-Cement 9 Other (specify below)
7 Fiberglass

	Welded	
	Threaded	Flush

Blank casing diameter	1	in. to	5.9	ft., Dia	in. to	ft., Dia	in. to	ft.
Casing height above land surface	0	in., weight	0.703	lbs./ft. Wall thickness or gauge No.	SCH. 40			

TYPE OF SCREEN OR PERFORATION MATERIAL:

1 Steel	3 Stainless steel	5 Fiberglass	8 RMP (SR)	11 Other (specify) _____
2 Brass	4 Galvanized steel	6 Concrete tile	9 ABS	12 None used (open hole)

SCREEN OR PERFORATION OPENINGS ARE:

1 Continuous slot	3 Mill slot	6 Wire wrapped	9 Drilled holes
2 Louvered shutter	4 Key punched	7 Torch cut	10 Other (specify)

SCREEN-PERFORATED INTERVALS:	From	5.9	ft. to	15.9	ft. From		ft. to		ft.
	From		ft. to		ft. From		ft. to		ft.
GRAVEL PACK INTERVALS:	From	4.9	ft. to	16	ft. From		ft. to		ft.
	From		ft. to		ft. From		ft. to		ft.

6	GROUT MATERIAL:	1 Neat cement	2 Cement grout	3 Bentonite	4 Other
---	-----------------	---------------	----------------	-------------	---------

Grout Intervals	From	ft. to	ft.	From	ft. to	ft.	From	ft. to	ft.
	1	4.9							

What is the nearest source of possible contamination:

1 Septic tank	4 Lateral lines	7 Pit privy	11 Fuel storage	15 Oil well/ Gas well
2 Sewer lines	5 Cess pool	8 Sewage lagoon	12 Fertilizer storage	16 Other (specify below)
3 Watertight sewer lines	6 Seepage pit	9 Feedyard	13 Insecticide storage	

Direction from well?

How many feet?

[illegible]

7 CONTRACTOR'S OR LANDOWNER'S CERTIFICATION: This water well was (1) constructed, (2) reconstructed, or (3) plugged under my jurisdiction and was completed on (mo/day/yr) 08/02/12 and this record is true to the best of my knowledge and belief. Kansas

Water Well Contractor's License No. **531** This Water Well Record was completed on (mo/day/yr) **08/27/12**
under the business name of **GSI Engineering, LLC** by (signature) 

INSTRUCTIONS: Please fill in blanks and circle the correct answers. Send three copies to Kansas Department of Health and Environment, Bureau of Water, 1000 S.W. Jackson St., Ste. 420, Topeka, Kansas 66612-1367. Telephone: 913-295-5545. Send one to WATER WELL OWNER and retain one for your records.