


2801 S. Rock Road . McConnell Air Force Base, Wichita

Application Number:

**29.10** ft. ELEVATION:

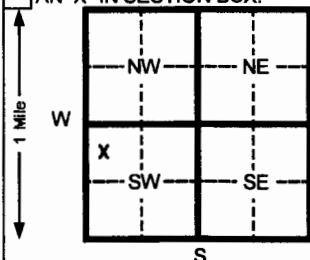

Was a chemical/bacteriological sample submitted to Department? Yes No **X** If yes, mo/day/yr sample was

Water Well Disinfected? Yes No **X**

10. Other (specify) \_\_\_\_\_