


8301 Oak Knoll – Wichita

Board of Agriculture, Division of Water Resources

Application Number:

1391.26 (TOC)

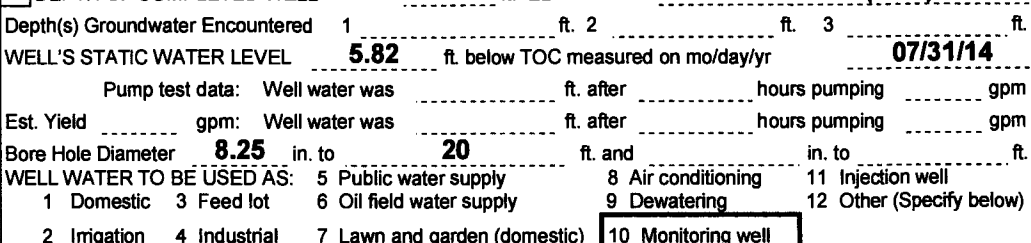

Was a chemical/bacteriological sample submitted to Department? Yes _____ No **X** If yes, mo/day/yr sample was submitted _____

Water Well Disinfected? Yes _____ No **X**

Clamped

Flush

10 Asbestos-cement

12 None used (open hole)

11 None (open hole)

10 Other (specify)

	From	ft. to	ft.	From	ft. to	ft.
1						
2						
4 Other

What is the nearest source of possible contamination:

14 Abandoned water well

16 Other (specify below)

How many feet?

[illegible]

This Water Well Record was completed on (mo/day/yr) **08/27/14**

Sark Wab

INSTRUCTIONS: Please fill in blanks and circle the correct answers. Send three copies to Kansas Department of Health and Environment, Bureau of Water, 1000 S W Jackson St. Ste. 420, Topeka, Kansas 66612-1367. Telephone: 913-296-5545. Send one to WATER WELL OWNER and retain one for your records.