

SS01-MW 23R

WATER WELL RECORD


Form WWC-5

Division of Water Resources App. No.

1 LOCATION OF WATER WELL: County: Sedgwick, Fraction 1/4 NE 1/4 SW 1/4, Section Number 6, Township No. T 28 S, Range Number R 2 E

Street/Rural Address of Well Location; if unknown, distance & direction from nearest town or intersection: Well located within McConnell AFB, Wichita, KS. Global Positioning System (GPS) information: Latitude: 37.64089, Longitude: 97.25324

2 WATER WELL OWNER: 22 CEI/CEIER, RR#, Street Address, Box #: 15657830 Pittsburg St. Suite 120, City, State, ZIP Code: McConnell AFB, KS 67221-3617. Datum: WGS 84, Collection Method: GPS unit (Make/Model: Garmin 60C)

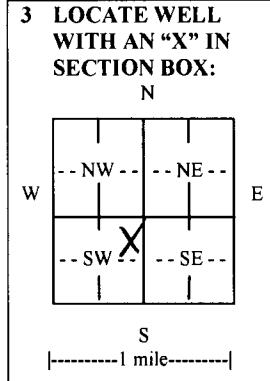

3 LOCATE WELL WITH AN 'X' IN SECTION BOX: 4 DEPTH OF COMPLETED WELL 22 ft. Depth(s) Groundwater Encountered (1) 22 ft. (2) ft. (3) ft. WELL'S STATIC WATER LEVEL 22 ft. below land surface measured on mo/day/yr. garden, Monitoring well. Was a chemical/bacteriological sample submitted to Department? Yes No. If yes, mo/day/yr sample was submitted. Water well disinfected? Yes No

5 TYPE OF CASING USED: Steel PVC Other. CASING JOINTS: Glued Clamped Welded Threaded. Casing diameter 2 in. to 12.0 ft., Diameter in. to ft., Diameter in. to ft. Casing height above land surface Flush in., Weight lbs./ft., Wall thickness or gauge No. Sch. 40. TYPE OF SCREEN OR PERFORATION MATERIAL: Steel Stainless Steel PVC Other (Specify). SCREEN OR PERFORATION OPENINGS ARE: Continuous slot Mill slot Gauze wrapped Torch cut Drilled holes None (open hole). Louvered shutter Key punched Wire wrapped Saw cut Other (specify). SCREEN-PERFORATED INTERVALS: From 22.0 ft. to 12.0 ft., From ft. to ft., From ft. to ft. GRAVEL PACK INTERVALS: From 23.0 ft. to 10.0 ft., From ft. to ft., From ft. to ft.

6 GROUT MATERIAL: Neat cement Cement grout Bentonite Other. Grout Intervals: From 10.0 ft. to 8.0 ft., From 8.0 ft. to 2.0 ft., From ft. to ft. What is the nearest source of possible contamination: Septic tank Lateral lines Pit privy Livestock pens Insecticide storage Other (specify below), Sewer lines Cesspool Sewage lagoon Fuel storage Abandoned water well, Watertight sewer lines Seepage pit Feedyard Fertilizer storage Oil well/gas well. Direction from well Distance from well

Table with columns: FROM, TO, LITHOLOGIC LOG, FROM, TO, LITHO. LOG (cont.) or PLUGGING INTERVALS. Row 1: 0, 23, Clay, , , , , , .

7 CONTRACTOR'S OR LANDOWNER'S CERTIFICATION: This water well was constructed, reconstructed, or plugged under my jurisdiction and was completed on (mo/day/year) 11/5/2014 and this record is true to the best of my knowledge and belief. Kansas Water Well Contractor's License No. 710. This Water Well Record was completed on (mo/day/year) 12/27/2014 under the business name of Below Ground Surface, Inc. by (signature) [Signature]

INSTRUCTIONS: Use typewriter or ball point pen. PLEASE PRESS FIRMLY and PRINT clearly. Please fill in blanks and check the correct answers. Send three copies (white, blue, pink) to Kansas Department of Health and Environment, Bureau of Water, Geology Section, 1000 SW Jackson St., Suite 420, Topeka, Kansas 66612-1367. Telephone 785-296-5524. Send one copy to WATER WELL OWNER and retain one for your records. I include fee of \$5.00 for each constructed well. Visit us at http://www.kdheks.gov/waterwell/index.html.