

County: Sedgwick Fraction SE SE NE SW Sec. 6 T 28 S R 2 EW

**CORRECTION(S) TO WATER WELL COMPLETION RECORD (WWC-5)**  
(to rectify lacking or incorrect information)

Owner: McConnell AFB

Location was listed as:

Location changed to:

Section-Township-Range: None Given

6-28S-2E

Fraction (1/4 1/4 1/4): \_\_\_\_\_

SE SE NE SW

Other changes: Initial statements: \_\_\_\_\_

Changed to: \_\_\_\_\_

Comments: \_\_\_\_\_

Verification method: Latitude & longitude, KGS' "LEO" conversion tool, and mapping tool on KGS website.

initials: AAJ date: 9/22/2015

Submitted by: Kansas Geological Survey, Data Resources Library, 1930 Constant Ave., Lawrence, KS 66047-3726  
to: Kansas Dept of Health & Environment, Bureau of Water, 1000 SW Jackson, Suite 420, Topeka, KS 66612-1367.

WATER WELL RECORD

Form WWC-5


Division of Water Resources App. No.

SS01-IW37

1 LOCATION OF WATER WELL: County: Sedgwick, Fraction 1/4 1/4 1/4 1/4, Section Number, Township No. T S, Range Number R E W

Street/Rural Address of Well Location; if unknown, distance & direction from nearest town or intersection: If at owner's address, check here [ ] McConnell AFB, Global Positioning System (GPS) information: Latitude: 37.6398752, Longitude: -097.2533997, Elevation: 1367.99 TOC, 1368.14 MED

2 WATER WELL OWNER: McConnell AFB, RR#, Street Address, Box #: , City, State, ZIP Code : , Datum: [ ] WGS 84, [x] NAD 83, [ ] NAD 27, Collection Method: [ ] GPS unit, [ ] Digital Map/Photo, [ ] Topographic Map, [x] Land Survey

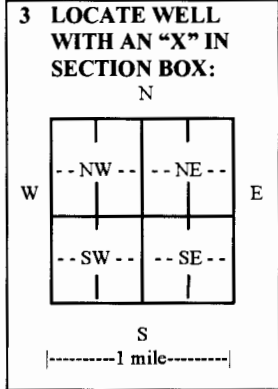

3 LOCATE WELL WITH AN 'X' IN SECTION BOX: N, W, E, S, 4 DEPTH OF COMPLETED WELL 25 ft., Depth(s) Groundwater Encountered (1) 7 ft., WELL'S STATIC WATER LEVEL 7 ft., EST. YIELD 4.5 gpm, Bore Hole Diameter 4.5 in. to 25 ft., WELL WATER TO BE USED AS: [ ] Public water supply, [x] Injection well, [ ] Domestic, [ ] Feedlot, [ ] Oil field water supply, [ ] Dewatering, [ ] Other, [ ] Irrigation, [ ] Industrial, [ ] Domestic-lawn & garden, [ ] Monitoring well, Was a chemical/bacteriological sample submitted to Department? [ ] Yes [ ] No, Water well disinfected? [ ] Yes [x] No

5 TYPE OF CASING USED: [ ] Steel [x] PVC [ ] Other, CASING JOINTS: [ ] Glued [ ] Clamped [ ] Welded [x] Threaded, Casing diameter 2 in. to 10 ft., Casing height above land surface 0 in., TYPE OF SCREEN OR PERFORATION MATERIAL: [ ] Steel [ ] Stainless Steel [x] PVC [ ] Other, SCREEN OR PERFORATION OPENINGS ARE: [x] Continuous slot [ ] Mill slot [ ] Gauze wrapped [ ] Torch cut [ ] Drilled holes [ ] None, SCREEN-PERFORATED INTERVALS: From 10 ft. to 20 ft., GRAVEL PACK INTERVALS: From 9 ft. to 25 ft.

6 GROUT MATERIAL: [x] Neat cement [ ] Cement grout [ ] Bentonite [ ] Other, Grout Intervals: From 0 ft. to 9 ft., What is the nearest source of possible contamination: [ ] Septic tank [ ] Lateral lines [ ] Pit privy [ ] Livestock pens [ ] Insecticide storage [ ] Other, [ ] Sewer lines [ ] Cesspool [ ] Sewage lagoon [ ] Fuel storage [ ] Abandoned water well, [ ] Watertight sewer lines [ ] Seepage pit [ ] Feedyard [ ] Fertilizer storage [ ] Oil well/gas well, Direction from well, Distance from well

Table with 6 columns: FROM, TO, LITHOLOGIC LOG, FROM, TO, LITHO. LOG (cont.) or PLUGGING INTERVALS. Row 1: 0, 25, Gray Clay, empty, empty, empty.

7 CONTRACTOR'S OR LANDOWNER'S CERTIFICATION: This water well was [x] constructed, [ ] reconstructed, or [ ] plugged under my jurisdiction and was completed on (mo/day/year) 10/17/14, Kansas Water Well Contractor's License No. 890, This Water Well Record was completed on (mo/day/year) 12/30/14 under the business name of ARS Technologies, Inc. by (signature) [Signature]

INSTRUCTIONS: Use typewriter or ball point pen. PLEASE PRESS FIRMLY and PRINT clearly. Please fill in blanks and check the correct answers. Send one copy to Kansas Department of Health and Environment, Bureau of Water, Geology Section, 1000 SW Jackson St., Suite 420, Topeka, Kansas 66612-1367. Telephone 785-296-5524. Send one copy to WATER WELL OWNER and retain one for your records. Include fee of \$5.00 for each constructed well. Visit us at http://www.kdheks.gov/waterwell/index.html