

WATER WELL RECORD Form WWC-5


Division of Water Resources App. No.

Well ID

Original Record Correction Change in Well Use

1 LOCATION OF WATER WELL: County: Sedgwick Fraction 1/4 1/4 SW 1/4 SE 1/4 Section Number 6 Township Number T 28 S Range Number R 2 E W

2 WELL OWNER: Last Name: Business: 22 CEI/CEIER Address: 15657830 Pittsburg St., Suite 120 City: McConnell AFB State: KS ZIP: 67221-3617 Street or Rural Address where well is located: Well located within McConnell AFB, Wichita, KS

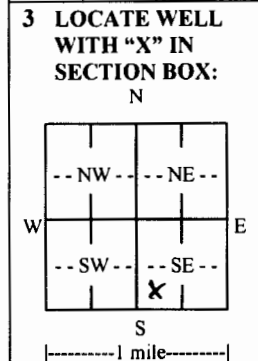

3 LOCATE WELL WITH 'X' IN SECTION BOX: N W E S
4 DEPTH OF COMPLETED WELL: 25.0 ft. Depth(s) Groundwater Encountered: 1) ... ft. 2) ... ft. 3) ... ft., or 4) Dry Well
WELL'S STATIC WATER LEVEL: ... ft.
Pump test data: Well water was ... ft. after ... hours pumping ... gpm
Well water was ... ft. after ... hours pumping ... gpm
Estimated Yield: ... gpm
Bore Hole Diameter: 8.25 in. to 26.0 ft. and ... in. to ... ft.

5 Latitude: 37.63583 (decimal degrees) Longitude: 97.24984 (decimal degrees) Horizontal Datum: WGS 84 NAD 83 NAD 27 Source for Latitude/Longitude: GPS (unit make/model: Garmin) (WAAS enabled? Yes No) Land Survey Topographic Map Online Mapper:
6 Elevation: ... ft. Ground Level TOC Source: Land Survey GPS Topographic Map Other

7 WELL WATER TO BE USED AS: 1. Domestic: Household Lawn & Garden Livestock Irrigation Feedlot Industrial
2. Public Water Supply: well ID
3. Dewatering: how many wells?
4. Aquifer Recharge: well ID
5. Monitoring: well ID OT547 - MW42
6. Environmental Remediation: well ID Air Sparge Soil Vapor Extraction Recovery Injection
7. Oil Field Water Supply: lease
8. Test Hole: well ID Cased Uncased Geotechnical
9. Geothermal: how many bores? Closed Loop Horizontal Vertical Open Loop Surface Discharge Inj. of Water
10. Other (specify):

Was a chemical/bacteriological sample submitted to KDHE? Yes No If yes, date sample was submitted:
Water well disinfected? Yes No

8 TYPE OF CASING USED: Steel PVC Other CASING JOINTS: Glued Clamped Welded Threaded
Casing diameter 2.0 in. to 14.8 ft., Diameter in. to ... ft., Diameter in. to ... ft.
Casing height above land surface -0.2 in. Weight ... lbs./ft. Wall thickness or gauge No. Sch. 40
TYPE OF SCREEN OR PERFORATION MATERIAL: Steel Stainless Steel Fiberglass PVC Other (Specify)
Brass Galvanized Steel Concrete tile None used (open hole)
SCREEN OR PERFORATION OPENINGS ARE: Continuous Slot Mill Slot Gauze Wrapped Torch Cut Drilled Holes Other (Specify)
Louvered Shutter Key Punched Wire Wrapped Saw Cut None (Open Hole)
SCREEN-PERFORATED INTERVALS: From 24.8 ft. to 14.8 ft., From ... ft. to ... ft., From ... ft. to ... ft.
GRAVEL PACK INTERVALS: From 26.0 ft. to 12.0 ft., From ... ft. to ... ft., From ... ft. to ... ft.

9 GROUT MATERIAL: Neat cement Cement grout Bentonite Other
Grout Intervals: From 12.0 ft. to 8.8 ft., From 8.8 ft. to 1.8 ft., From ... ft. to ... ft.
Nearest source of possible contamination: Septic Tank Lateral Lines Pit Privy Livestock Pens Insecticide Storage
Sewer Lines Cess Pool Sewage Lagoon Fuel Storage Abandoned Water Well
Watertight Sewer Lines Seepage Pit Feedyard Fertilizer Storage Oil Well/Gas Well
Other (Specify)
Direction from well? Distance from well? ft.

Table with 6 columns: 10 FROM, TO, LITHOLOGIC LOG, FROM, TO, LITHO. LOG (cont.) or PLUGGING INTERVALS. Row 1: 0, 26, Clay. Includes a Notes section.

11 CONTRACTOR'S OR LANDOWNER'S CERTIFICATION: This water well was constructed, reconstructed, or plugged under my jurisdiction and was completed on (mo-day-year) 6/17/2015 and this record is true to the best of my knowledge and belief. Kansas Water Well Contractor's License No. 710 This Water Well Record was completed on (mo-day-year) 7/3/2015 under the business name of Below Ground Surface, Inc.

Mail 1 white copy along with a fee of \$5.00 for each constructed well to: Kansas Department of Health and Environment, Bureau of Water, GWTS Section, 1000 SW Jackson St., Suite 420, Topeka, Kansas 66612-1367. Mail one to Water Well Owner and retain one for your records. Telephone 785-296-5524. Visit us at http://www.kdheks.gov/waterwell/index.html KSA 82a-1212 Revised 1/20/2015