

State

WATER WELL RECORD Form WWC-5


Division of Water Resources App. No.

Well ID

Original Record Correction Change in Well Use

1 LOCATION OF WATER WELL: County: Sedgwick Fraction SW 1/4 SW 1/4 SE 1/4 NE 1/4 Section Number 31 Township Number T 28 S Range Number RA 2E W

2 WELL OWNER: Last Name: Molt First: Wayne Street or Rural Address where well is located: 2206 N. Woodard St City: Derby State: KS ZIP: 67037

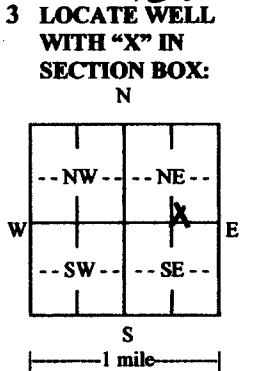

4 DEPTH OF COMPLETED WELL: 90 ft. Depth(s) Groundwater Encountered: 1) 24 ft. 2) ... ft. 3) ... ft. 4) Dry Well

5 Latitude: 37.5699324 Longitude: 97.2482665 Datum: WGS 84 NAD 83 NAD 27

6 Elevation: ... ft. Ground Level TOC Source: Land Survey GPS Topographic Map Other

7 WELL WATER TO BE USED AS: 1. Domestic: Household Lawn & Garden Livestock 2. Irrigation 3. Feedlot 4. Industrial 5. Public Water Supply 6. Dewatering 7. Aquifer Recharge 8. Monitoring 9. Environmental Remediation 10. Oil Field Water Supply 11. Test Hole 12. Geothermal 13. Other

Was a chemical/bacteriological sample submitted to KDHE? No Water well disinfected? Yes

8 TYPE OF CASING USED: Steel PVC Other CASING JOINTS: Glued Clamped Welded Threaded Casing diameter 5 in. to 90 ft. Casing height above land surface 12 in. Weight 160 lbs/ft. Wall thickness or gauge No. 26

TYPE OF SCREEN OR PERFORATION MATERIAL: Steel Stainless Steel Fiberglass PVC Other (Specify) Brass Galvanized Steel Concrete tile None used (open hole)

SCREEN OR PERFORATION OPENINGS ARE: Continuous Slot Mill Slot Gauze Wrapped Torch Cut Drilled Holes Other (Specify) Louvered Shutter Key Punched Wire Wrapped Saw Cut None (Open Hole)

SCREEN-PERFORATED INTERVALS: From 70 ft. to 90 ft. GRAVEL PACK INTERVALS: From 24 ft. to 90 ft.

9 GROUT MATERIAL: Neat cement Cement grout Bentonite Other Grout Intervals: From 4 ft. to 24 ft.

Nearest source of possible contamination: Septic Tank Lateral Lines Pit Privy Livestock Pens Insecticide Storage Sewer Lines Cess Pool Sewage Lagoon Fuel Storage Abandoned Water Well Watertight Sewer Lines Seepage Pit Feedyard Fertilizer Storage Oil Well/Gas Well Other (Specify) Direction from well? North Distance from well? 55 ft.

Table with 6 columns: FROM, TO, LITHOLOGIC LOG, FROM, TO, LITHO. LOG (cont.) or PLUGGING INTERVALS. Rows include Top Soil, Clay, fine sand, clay, med. sand, shale.

11 CONTRACTOR'S OR LANDOWNER'S CERTIFICATION: This water well was constructed, reconstructed, or plugged under my jurisdiction and was completed on (mo-day-year) 8-15-15 and this record is true to the best of my knowledge and belief. Kansas Water Well Contractor's License No. 6011 This Water Well Record was completed on (mo-day-year) 9-10-15 under the business name of Chase Drilling