

WATER WELL RECORD Form WWC-5


Division of Water Resources App. No.

Well ID

Original Record Correction Change in Well Use

1 LOCATION OF WATER WELL: County: Sedgwick Fraction 1/4 NW 1/4 NW 1/4 SE 1/4 Section Number 6 Township Number T 28 S Range Number R 2 E W

2 WELL OWNER: Last Name: Business: 22 CEI/CEIER Address: 15657830 Pittsburg St., Suite 120 City: McConnell AFB State: KS ZIP: 67221-3617 Street or Rural Address where well is located (if unknown, distance and direction from nearest town or intersection): If at owner's address, check here: Well located within McConnell AFB, Wichita, KS

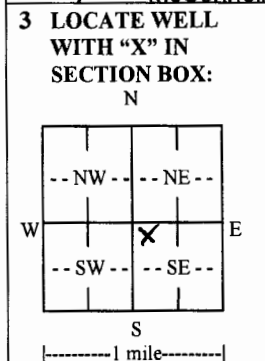

3 LOCATE WELL WITH 'X' IN SECTION BOX: N W E S. 4 DEPTH OF COMPLETED WELL: 24.0 ft. Depth(s) Groundwater Encountered: 1) ft. 2) ft. 3) ft., or 4) Dry Well WELL'S STATIC WATER LEVEL: ft. below land surface, measured on (mo-day-yr) ft. above land surface, measured on (mo-day-yr) ft. Pump test data: Well water was ft. after hours pumping gpm Well water was ft. after hours pumping gpm Estimated Yield: gpm Bore Hole Diameter: 8.25 in. to 24.0 ft. and in. to ft.

5 Latitude: 37.64191 (decimal degrees) Longitude: 97.25281 (decimal degrees) Horizontal Datum: WGS 84 NAD 83 NAD 27 Source for Latitude/Longitude: GPS (unit make/model: Garmin 60c (WAAS enabled? Yes No) Land Survey Topographic Map Online Mapper. 6 Elevation: ft. Ground Level TOC Source: Land Survey GPS Topographic Map Other

7 WELL WATER TO BE USED AS: 1. Domestic: Household Lawn & Garden Livestock Irrigation Feedlot Industrial. 2. Public Water Supply: well ID. 3. Dewatering: how many wells? 4. Aquifer Recharge: well ID. 5. Monitoring: well ID B971-MW2R. 6. Environmental Remediation: well ID. 7. Air Sparge Soil Vapor Extraction Recovery Injection. 8. Oil Field Water Supply: lease. 9. Test Hole: well ID. 10. Cased Uncased Geotechnical. 11. Geothermal: how many bores? 12. Closed Loop Horizontal Vertical. 13. Open Loop Surface Discharge Inj. of Water. 14. Other (specify):

Was a chemical/bacteriological sample submitted to KDHE? Yes No If yes, date sample was submitted: Water well disinfected? Yes No

8 TYPE OF CASING USED: Steel PVC Other CASING JOINTS: Glued Clamped Welded Threaded Casing diameter 2.0 in. to 12.8 ft., Diameter in. to ft., Diameter in. to ft. Casing height above land surface -0.6 in. Weight lbs./ft. Wall thickness or gauge No. Sch. 40. TYPE OF SCREEN OR PERFORATION MATERIAL: Steel Stainless Steel Fiberglass PVC Other (Specify) Brass Galvanized Steel Concrete tile None used (open hole) SCREEN OR PERFORATION OPENINGS ARE: Continuous Slot Mill Slot Gauze Wrapped Torch Cut Drilled Holes Other (Specify) Louvered Shutter Key Punched Wire Wrapped Saw Cut None (Open Hole) SCREEN-PERFORATED INTERVALS: From 22.8 ft. to 12.8 ft., From ft. to ft., From ft. to ft. GRAVEL PACK INTERVALS: From 24.0 ft. to 10.8 ft., From ft. to ft., From ft. to ft.

9 GROUT MATERIAL: Neat cement Cement grout Bentonite Other Grout Intervals: From 10.8 ft. to 7.10 ft., From 7.10 ft. to 0.9 ft., From ft. to ft. Nearest source of possible contamination: Septic Tank Lateral Lines Pit Privy Livestock Pens Insecticide Storage Sewer Lines Cess Pool Sewage Lagoon Fuel Storage Abandoned Water Well Watertight Sewer Lines Seepage Pit Feedyard Fertilizer Storage Oil Well/Gas Well Other (Specify) Direction from well? Distance from well? ft.

Table with columns: FROM, TO, LITHOLOGIC LOG, FROM, TO, LITHO. LOG (cont.) or PLUGGING INTERVALS. Row 1: 0, 24.0, Clay. Notes section below.

11 CONTRACTOR'S OR LANDOWNER'S CERTIFICATION: This water well was constructed, reconstructed, or plugged under my jurisdiction and was completed on (mo-day-year) 5/17/2016 and this record is true to the best of my knowledge and belief. Kansas Water Well Contractor's License No. 710. This Water Well Record was completed on (mo-day-year) 6/15/2016 under the business name of Below Ground Surface, Inc.