


WATER WELL RI		** ** C-3	013041		sion of Water		W 11 ID		
		ge in Well Use			irces App. No.	T 1: N 1	Well ID	NY 1	
1 LOCATION OF WA	Fraction	1/. 1/.	Secti	ion Number	Township Numb		ige Number		
County:	1/4 1/4	1/4 1/4	D	1 4 1 1 1	T S	R	□E □W		
2 WELL OWNER: La Business:	First:								
Address:	direction from nearest town or intersection): If at owner's address, check here							ineck nere:	
Address:									
City:	State:	ZIP:			_				
3 LOCATE WELL 4 DEPTH OF COMPLETED WELL:					5 Lotitud	· ·		(daaimal daamaa)	
WITH "X" IN									
SECTION BOX: Depth(s) Groundwater Encountered: 1)									
WELL'S STATIC WATER LEVEL:									
	□ below land surface, measured on (mo-day-yr				····· GPS (unit make/model:)				
above land surface, measured on (mo-day-yr) (WAAS enabled? \(\subseteq \text{ Yes} \subseteq \text{ No)}					
	Pump test data: Well water was ft.				☐ Land Survey ☐ Topographic Map				
WE	after hours			☐ Online Mapper:					
SWX SE	Well w								
	after hours pumping			6 Elevation:ft. ☐ Ground Level ☐ TOC					
S	Bore Hole Diameter: in. to f								
mile	in. to ft				Other				
7 WELL WATER TO BE USED AS:									
1. Domestic:		ter Supply: well ID)		10. □ Oil F	ield Water Supply: 1	ease		
☐ Household	6. Dewaterin								
☐ Lawn & Garden	7. 🗌 Aquifer Re								
Livestock	8. Monitoring								
2. Irrigation	9. Environmental Remediation: well ID								
3. Feedlot					b) Open Loop Surface Discharge Inj. of Water				
4. Industrial Recovery Injection 13. Other (specify):									
Was a chemical/bacteriological sample submitted to KDHE? ☐ Yes ☐ No If yes, date sample was submitted:									
Water well disinfected?									
8 TYPE OF CASING USED: Steel PVC Other									
Casing diameter									
Casing height above land surface									
☐ Steel ☐ Stainless Steel ☐ Fiberglass ☐ PVC ☐ Other (Specify)									
☐ Brass ☐ Galvanized Steel ☐ Concrete tile ☐ None used (open hole)									
SCREEN OR PERFORATION OPENINGS ARE:									
☐ Continuous Slot ☐ Mill Slot ☐ Gauze Wrapped ☐ Torch Cut ☐ Drilled Holes ☐ Other (Specify)									
☐ Louvered Shutter ☐ Key Punched ☐ Wire Wrapped ☐ Saw Cut ☐ None (Open Hole)									
SCREEN-PERFORATED INTERVALS: From									
GRAVEL PACK INTERVALS: From ft. to ft., From ft., From ft., From ft. to ft.									
9 GROUT MATERIAL: Neat cement Cement grout Bentonite Other									
Grout Intervals: From									
Nearest source of possible contamination: □ Septic Tank □ Lateral Lines □ Pit Privy □ Livestock Pens □ Insecticide Storage									
☐ Septic Tank☐ Sewer Lines	☐ Cess Pool				uel Storage				
□ Sewer Lines □ Cess Pool □ Sewage Lagoon □ Fuel Storage □ Abandoned Water Well □ Watertight Sewer Lines □ Seepage Pit □ Feedyard □ Fertilizer Storage □ Oil Well/Gas Well									
Other (Specify)									
Direction from well?		Distance from	m well?			ft			
10 FROM TO	LITHOLOG	GIC LOG	FRO	OM	TO LI	THO. LOG (cont.) o	r PLUGGIN	G INTERVALS	
			7.7						
Notes:									
11 CONTRACTOR'S OR LANDOWNER'S CERTIFICATION: This water well was ☐ constructed, ☐ reconstructed, or ☐ plugged									
under my jurisdiction and was completed on (mo-day-year)									
Kansas Water Well Contractor's License No									
under the business name	of					on (mo day y			
under the business name of Send one copy to WATER WELL OWNER and retain one for your records. Fee of \$5.00 for each constructed well.									
KS Department of Health and Environment, Bureau of Water, Geology Section, 1000 SW Jackson St., Suite 420, Topeka, Kansas 66612-1367. Telephone 785-296-3565.									

KSA 82a-1212 Visit us at http://www.kdheks.gov/waterwell/index.html

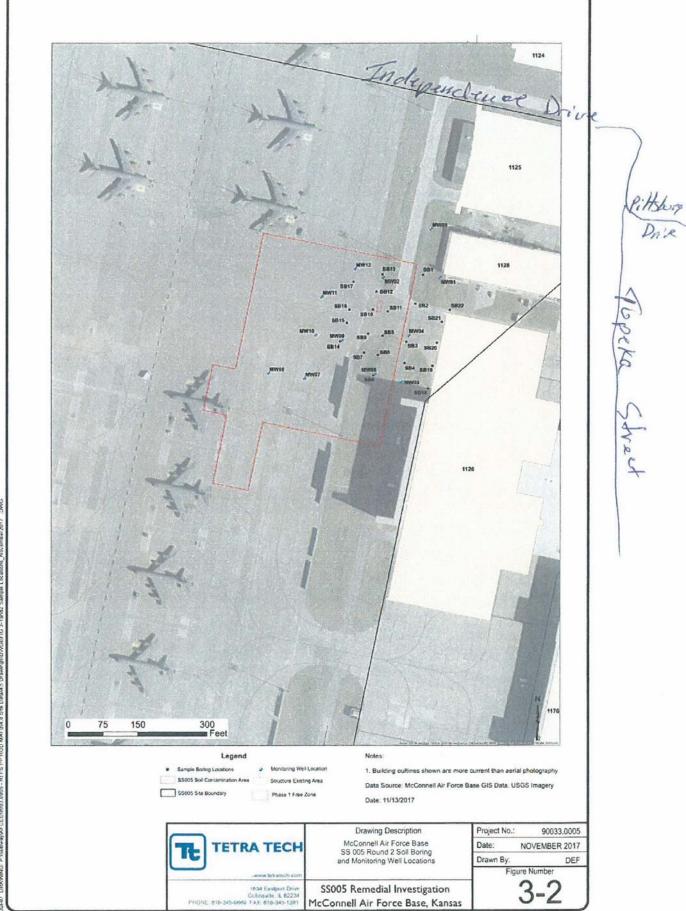

Copyright: Tetra Tech