


WATER WELL RECORD Form WWC-5 KSA 82a-1212

1 LOCATION OF WATER WELL: Sedgwick	FRACTION NW 1/4 SW 1/4 NW 1/4	SECTION NUMBER 30	TOWNSHIP NUMBER T 28 S	RANGE NUMBER R 2E E/W
--	---	-----------------------------	----------------------------------	---------------------------------

Distance and direction from nearest town or city street address of well if located within city?
836 E. Freedom St. Derby, Kansas

2 WATER WELL OWNER: KLAUSMEYER CONSTRUCTION	Board of Agriculture, Division of Water Resource
RR#, ST. ADDRESS, BOX #: 10008 W. York	ZIP CODE: 67215
CITY, STATE: Wichita, Kansas	Application Number:

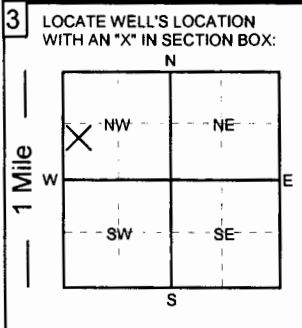

4 DEPTH OF COMPLETED WELL: 85 ft.	ELEVATION:
Depth of groundwater Encountered: _____ ft.	
WELL'S STATIC WATER LEVEL 30 FT. BELOW LAND SURFACE MEASURED ON 1/15/19	
Pump test data:	Well water was _____ ft. after _____ hours of pumping @ _____ gpm
Est. Yield: _____ gpm	Well water was _____ ft. after _____ hours of pumping @ _____ gpm
Bore Hole Diameter 12 in.	to 85 ft. and _____ in. to _____ ft.
WELL WATER TO BE USED AS:	
1. Domestic	3. Feedlot
2. Irrigation	4. Industrial
5. Public water supply	6. Oil field water supply
7. <u>Lawn and garden only</u>	8. Air conditioning
9. Dewatering	10. Monitoring well
11. Injection well	12. Other (Specify below)
Was a chemical/bacteriological sample submitted to Department? YES <u>NO</u> ; If yes, what _____ mo/day/yr was sample submitted	
Was Water Well Disinfected? <u>YES</u> NO	

5 TYPE OF CASING USED:	CASING JOINTS: <u>Glued</u> Threaded
1. Steel	2. <u>PVC</u>
3. RPM (SR)	4. ABS
5. Wrought Iron	6. Asbestos-Cement
7. Fiberglass	8. Concrete tile
9. Other (Specify below)	SDR-26
Blank casing diameter 5 in.	to 50 ft., Dia. _____ in.
Casing height above land surface: 12 in.,	Weight: 2.35 lbs. / ft.
Wall thickness or gauge No. .214	
TYPE OF SCREEN OR PERFORATION MATERIAL:	
1. Steel	2. Brass
3. Stainless Steel	4. Galvanized
5. Fiberglass	6. Concrete Tile
7. <u>PVC</u>	8. RMP (SR)
9. ABS	10. Asbestos-Cement
11. Other (specify)	12. None used (open hole)
SCREEN OR PERFORATION OPENINGS ARE:	
1. Continuous slot	2. Louvered shutter
3. Mill slot	4. Key punched
5. Gauzed wrapped	6. Wire wrapped
7. Torch cut	8. <u>Saw cut</u>
9. Drilled holes	10. Other (specify)
11. None (open hole)	
SCREEN - PERFORATION INTERVAL	
From 50 ft.	to 86 ft.,
From _____ ft.	to _____ ft.,
GRAVEL PACK INTERVALS:	
From 24 ft.	to 86 ft.,
From _____ ft.	to _____ ft.,

6 GROUT MATERIALS:	Other bentonite hole plug
1. Neat cement	2. Cement Grout
3. Bentonite	
Grout Intervals: From 4 ft. to 24 ft., From _____ ft. to _____ ft., From _____ ft. to _____ ft.	
What is the nearest source of possible contamination:	
1. Septic tank	2. Sewer lines
3. <u>Watertight sewer line</u>	4. Lateral lines
5. Cess Pool	6. Seepage pit
7. Pit privy	8. Sewage lagoon
9. Feed yard	10. Livestock pens
11. Fuel storage	12. Fertilizer storage
13. Insecticide storage	14. Abandon water well
15. Oil well/Gas well	16. Other (specify below)
Direction from well? North	
How many feet? 50 ft. plus	

From	To	LITHOLOGIC LOG	From	To	LITHOLOGIC LOG
0	3	topsoil			
3	48	clay			
48	55	fine sand			
55	86	gray shale			

7 Contractor's or Landowner's Certification: This water well was 1. <u>constructed</u> 2. reconstructed or 3. plugged under my jurisdiction and was completed on (mo/day/year) 1/15/19 and this record is true to the best of my knowledge and belief.	This water well record was completed on (mo/day/year) 1/17/19
Kansas Water Well Contractor's License No. 236	by (signature) Todd S. Harp
under the business name of Harp Well and Pump Service	