

WATER WELL RECORD Form WWC-5

Original Record Correction Change in Well Use

Division of Water Resources App. No.

Well ID

Well ID

1 LOCATION OF WATER WELL: County: Fraction Section Number Township Number Range Number

2 WELL OWNER: Last Name: Business: Address: City: State: ZIP: Street or Rural Address where well is located

3 LOCATE WELL WITH 'X' IN SECTION BOX: NW NE SW SE

4 DEPTH OF COMPLETED WELL: Depth(s) Groundwater Encountered: WELL'S STATIC WATER LEVEL: Pump test data: Estimated Yield: Bore Hole Diameter:

5 Latitude: Longitude: Datum: Source for Latitude/Longitude: 6 Elevation: Source:

7 WELL WATER TO BE USED AS: 1. Domestic: 2. Irrigation: 3. Feedlot: 4. Industrial: 5. Public Water Supply: 6. Dewatering: 7. Aquifer Recharge: 8. Monitoring: 9. Environmental Remediation: 10. Oil Field Water Supply: 11. Test Hole: 12. Geothermal: 13. Other (specify):

Was a chemical/bacteriological sample submitted to KDHE? Water well disinfected?


8 TYPE OF CASING USED: CASING JOINTS: TYPE OF SCREEN OR PERFORATION MATERIAL: SCREEN OR PERFORATION OPENINGS ARE: SCREEN-PERFORATED INTERVALS: GRAVEL PACK INTERVALS:

9 GROUT MATERIAL: Grout Intervals: Nearest source of possible contamination: Direction from well? Distance from well?


Table with 6 columns: FROM, TO, LITHOLOGIC LOG, FROM, TO, LITHO. LOG (cont.) or PLUGGING INTERVALS. Includes a Notes section.

11 CONTRACTOR'S OR LANDOWNER'S CERTIFICATION: This water well was constructed, reconstructed, or plugged under my jurisdiction and was completed on (mo-day-year) and this record is true to the best of my knowledge and belief.

DRAWING: P:\Subway\AFCEE\8903.0005 - RI FS PP ROD MAFB\4.0 Site Data\4.6 Drawings\DWG\GSI\Planning Figures\FIG X Round 4 December 2019 Proposed Sample Locations.DWG

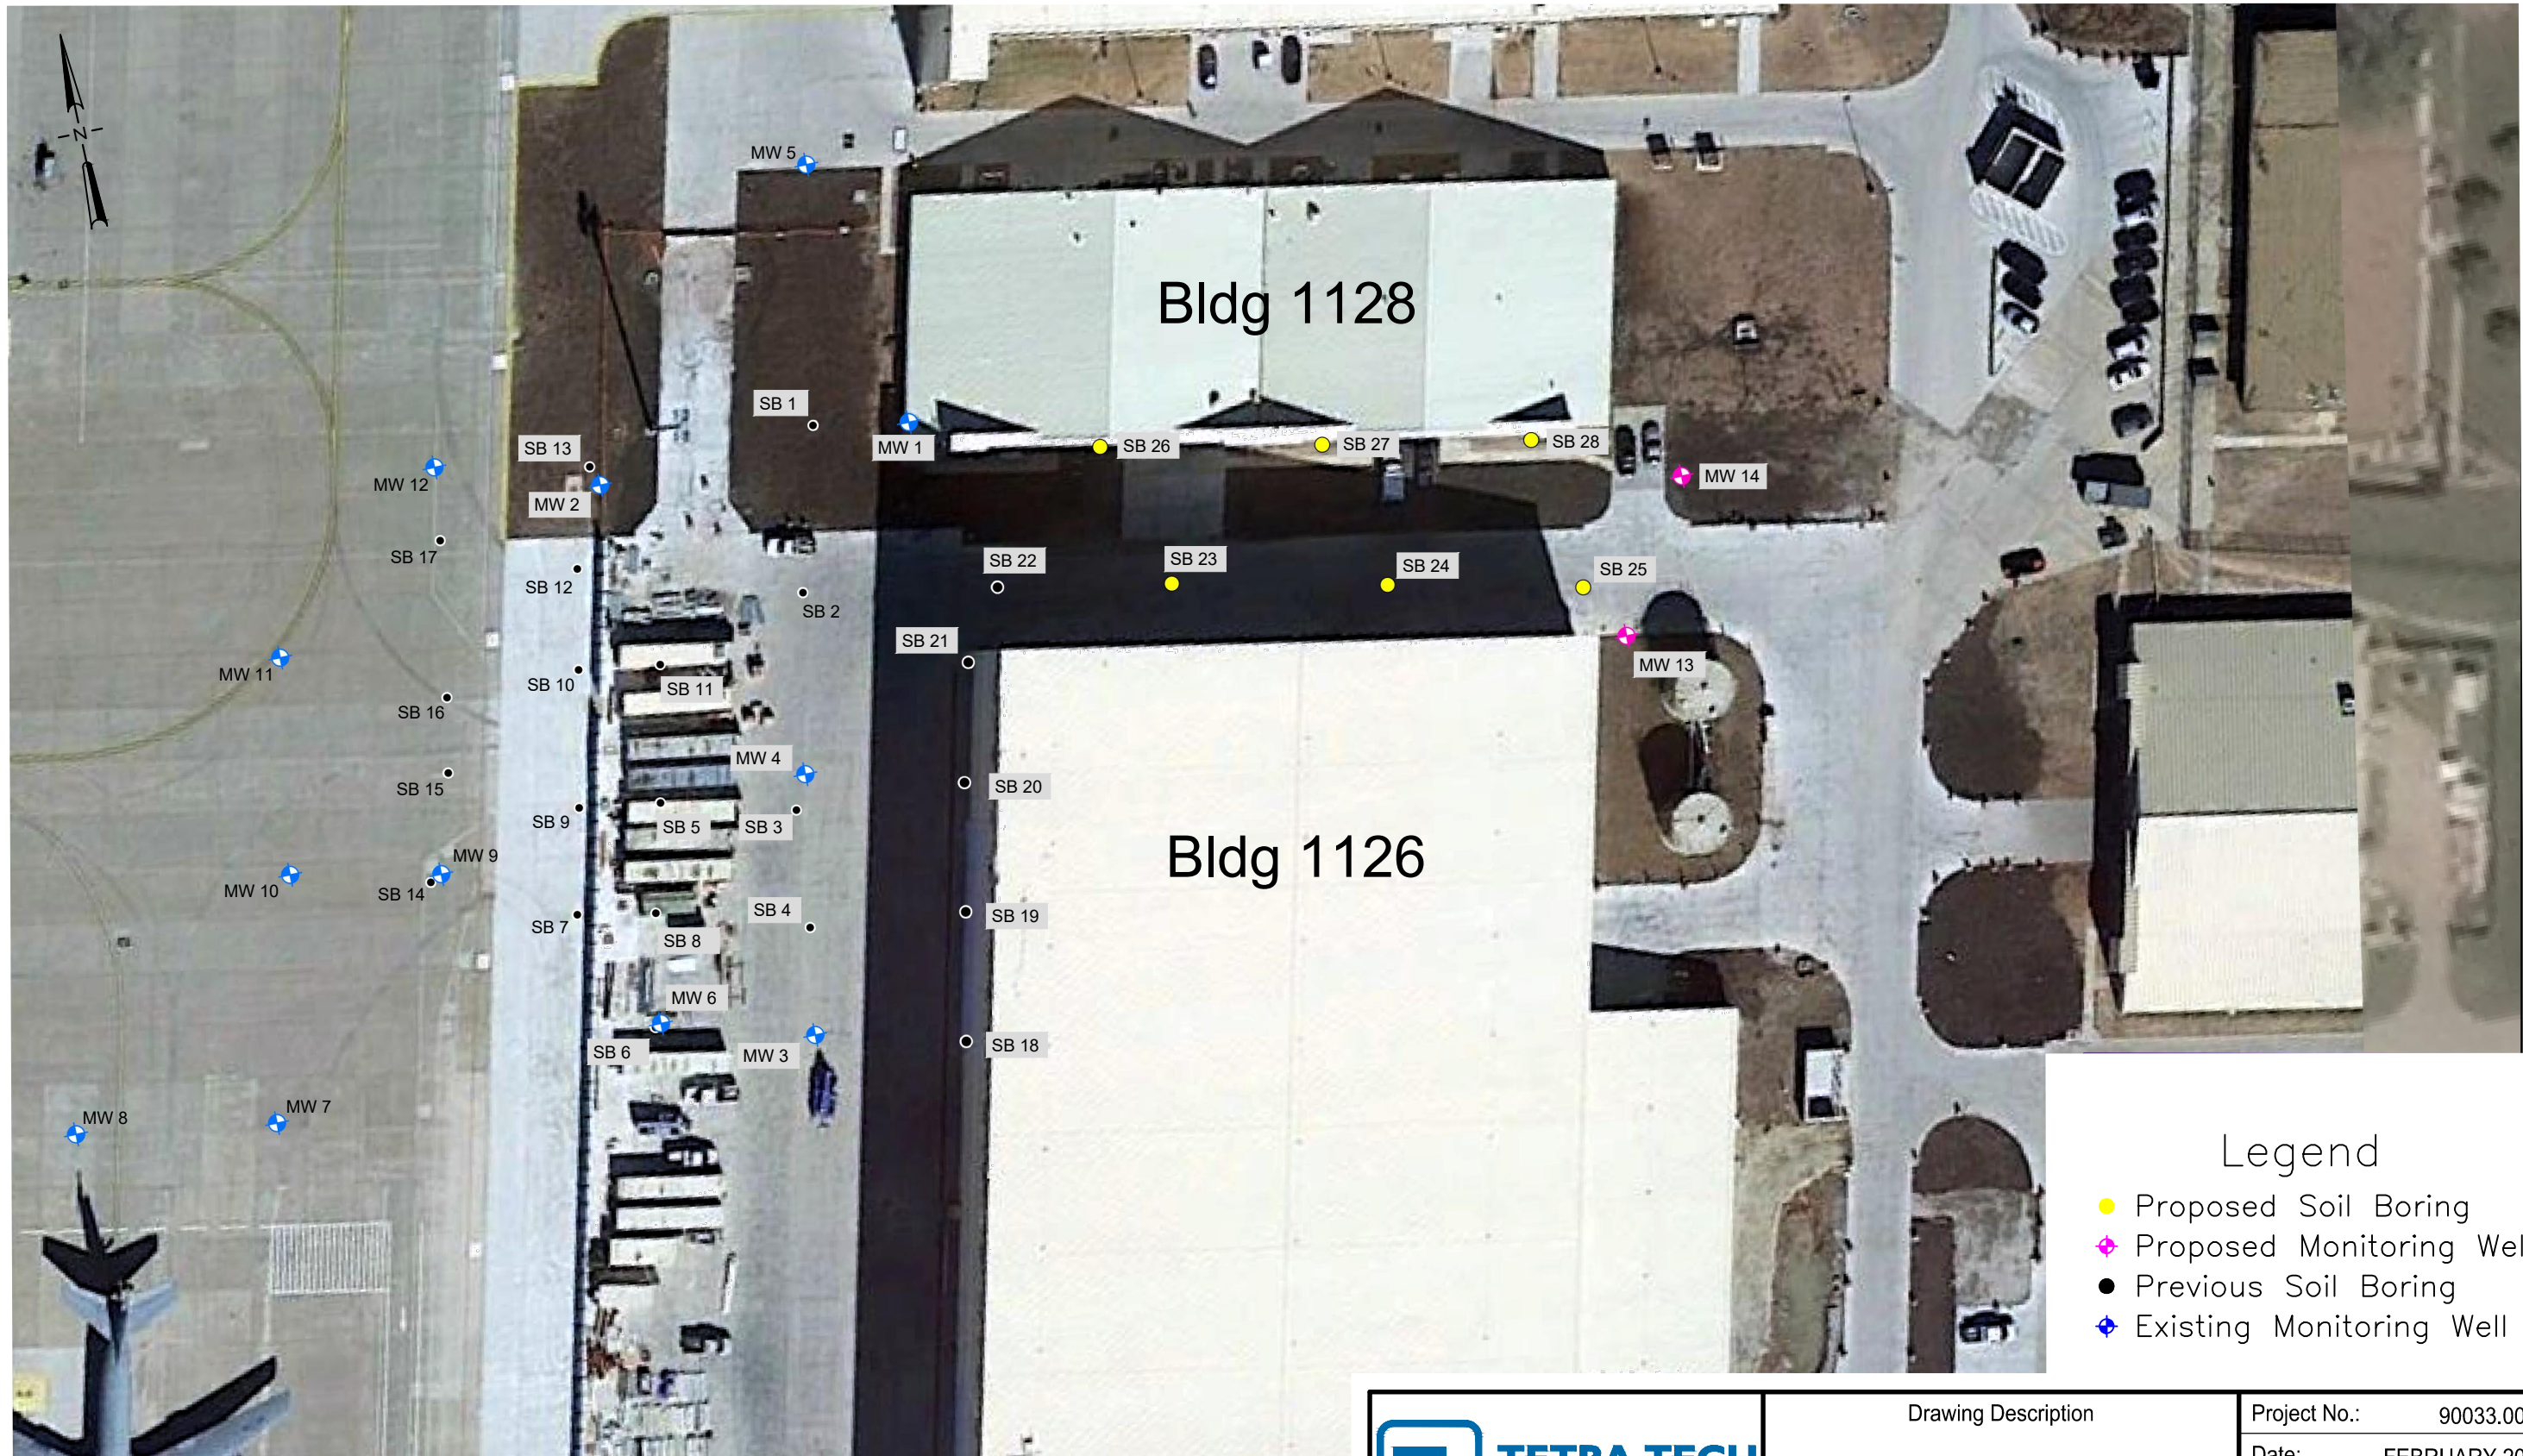

Source: Google Earth, Tetra Tech

 <p>www.tetrattech.com</p> <p>1634 Eastport Plaza Drive Collinsville, IL 62234 PHONE: 618-343-2300 FAX: 618-345-1281</p>	<p>Drawing Description</p> <p>McConnell Air Force Base SS 005 Round 4 Proposed Locations</p>	<p>Project No.: 90033.0005</p> <p>Date: FEBRUARY 2020</p> <p>Drawn By: DEF</p>
	<p>SS005 Remedial Investigation McConnell Air Force Base, Kansas</p>	<p>Figure Number</p> <p>4</p>

Copyright: Tetra Tech