


WATER WELL RECORD Form WWC-5

Division of Water Resources App. No. [] Well ID []

[X] Original Record [] Correction [] Change in Well

1 LOCATION OF WATER WELL: Use Fraction Section Number Township Number Range Number
County: Sedgwick SE 1/4 SW 1/4 NW 1/4 NW 1/4 30 T 28 S R 2 [X] E [] W

2 WELL OWNER: Last Name: First: Street or Rural Address where well is located
Business: KLAUSMEYER CONSTRUCTION LLC Address: 10008 W. York St.
Address: City: Wichita State: Kansas ZIP: 67215 825 E. Bellows St. Derby, Kansas 67037

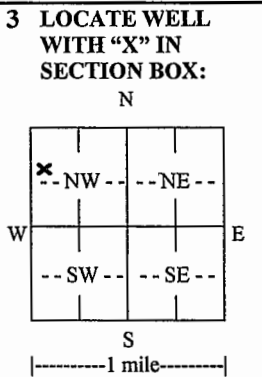

3 LOCATE WELL WITH 'X' IN SECTION BOX: N
4 DEPTH OF COMPLETED WELL: 85 ft.
Depth(s) Groundwater Encountered: 1) ... ft.
2) ... ft. 3) ... ft., or 4) [] Dry Well
WELL'S STATIC WATER LEVEL: 28 ft.
[] below land surface, measured on (mo-day-yr) 04/19/22.
[] above land surface, measured on (mo-day-yr) ...
Pump test data: Well water was ... ft.
after ... hours pumping ... gpm
Well water was ... ft.
after ... hours pumping ... gpm
Estimated Yield: ... gpm
Bore Hole Diameter: 12 in. to 85 ft. and ... in. to ... ft.

5 Latitude: 37.58878 (decimal degrees)
Longitude: -97.26023 (decimal degrees)
Horizontal Datum: [X] WGS 84 [] NAD 83 [] NAD 27
Source for Latitude/Longitude:
[] GPS (unit make/model: iPhone) (WAAS enabled? [] Yes [] No)
[] Land Survey [] Topographic Map
[] Online Mapper: ...

6 Elevation: ... ft. [] Ground Level [] TOC
Source: [] Land Survey [X] GPS [] Topographic Map
[] Other ...

7 WELL WATER TO BE USED AS:
1. Domestic: [] Household [X] Lawn & Garden [] Livestock
2. Irrigation
3. Feedlot
4. Industrial
5. [] Public Water Supply: well ID ...
6. [] Dewatering: how many wells? ...
7. [] Aquifer Recharge: well ID ...
8. [] Monitoring: well ID ...
9. Environmental Remediation: well ID ...
[] Air Sparge [] Soil Vapor Extraction [] Recovery [] Injection
10. [] Oil Field Water Supply: lease ...
11. Test Hole: well ID ...
[] Cased [] Uncased [] Geotechnical
12. Geothermal: how many bores? ...
a) Closed Loop [] Horizontal [] Vertical
b) Open Loop [] Surface Discharge [] Inj. of Water
13. [] Other (specify): ...

Was a chemical/bacteriological sample submitted to KDHE? [] Yes [X] No If yes, date sample was submitted: ...
Water well disinfected? [X] Yes [] No

8 TYPE OF CASING USED: [] Steel [X] PVC [] Other ... CASING JOINTS: [X] Glued [] Clamped [] Welded [] Threaded
Casing diameter .5 in. to .85 ft., Diameter ... in. to ... ft., Diameter ... in. to ... ft.
Casing height above land surface .12 in. Weight .2.35 lbs./ft. Wall thickness or gauge No. SDR-26

TYPE OF SCREEN OR PERFORATION MATERIAL:
[] Steel [] Stainless Steel [] Fiberglass [X] PVC [] Other (Specify) ...
[] Brass [] Galvanized Steel [] Concrete tile [] None used (open hole)
SCREEN OR PERFORATION OPENINGS ARE:
[] Continuous Slot [] Mill Slot [] Gauze Wrapped [] Torch Cut [] Drilled Holes [] Other (Specify) ...
[] Louvered Shutter [] Key Punched [] Wire Wrapped [X] Saw Cut [] None (Open Hole)
SCREEN-PERFORATED INTERVALS: From 60 ft. to 85 ft., From ... ft. to ... ft., From ... ft. to ... ft.
GRAVEL PACK INTERVALS: From 24 ft. to 85 ft., From ... ft. to ... ft., From ... ft. to ... ft.

9 GROUT MATERIAL: [] Neat cement [] Cement grout [X] Bentonite [] Other ...
Grout Intervals: From .4 ft. to .24 ft., From ... ft. to ... ft., From ... ft. to ... ft.
Nearest source of possible contamination:
[] Septic Tank [] Lateral Lines [] Pit Privy [] Livestock Pens [] Insecticide Storage
[] Sewer Lines [] Cess Pool [] Sewage Lagoon [] Fuel Storage [] Abandoned Water Well
[X] Watertight Sewer Lines [] Seepage Pit [] Feedyard [] Fertilizer Storage [] Oil Well/Gas Well
[] Other (Specify) ...
Direction from well? South Distance from well? 38 ft. plus ... ft.

Table with 6 columns: 10 FROM, TO, LITHOLOGIC LOG, FROM, TO, LITHO. LOG (cont.) or PLUGGING INTERVALS. Rows show soil layers: topsoil (0-3), clay (3-48), medium sand (48-60), gray shale (60-83), limestone (83-85). Includes a Notes section.

11 CONTRACTOR'S OR LANDOWNER'S CERTIFICATION: This water well was [X] constructed, [] reconstructed, or [] plugged under my jurisdiction and was completed on (mo-day-year) 04/19/2022. and this record is true to the best of my knowledge and belief.
Kansas Water Well Contractor's License No. 236 This Water Well Record was completed on (mo-day-year) 4/20/2022.
under the business name of Harp Well and Pump Service Signature Todd S. Harp