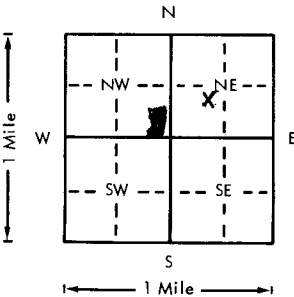
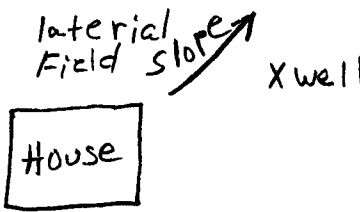


USE TYPEWRITER OR BALL
POINT PEN-PRESS FIRMLY,
PRINT CLEARLY.

WATER WELL RECORD
KSA 82a-1201-1215

Kansas Department of Health and
Environment-Division of Environment
(Water well Contractors)
Topeka, Kansas 66620

1. Location of well: County <u>Sedgwick</u>		Fraction <u>NW NE SW SE</u> 1/4 1/4 1/4		Section number <u>1</u>	Township number <u>T 28 S</u>	Range number <u>R 2 E</u>
2. Distance and direction from nearest town or city: <u>450 1W 1/2 S</u> <u>1/2 W of Mcdover Ks</u>				3. Owner of well: <u>John Gethen</u> R.R. or street: <u>NO 11 PONY Meadows Dr.</u> City, state, zip code: <u>Wichita Ks</u>		
4. Locate with "X" in section below:		Sketch map:		6. Bore hole dia. <u>8.5</u> in. Completion date <u>4-22-78</u> Well depth <u>78</u> ft.		
				7. ☒ Cable tool ☐ Rotary ☐ Driven ☐ Dug ☐ Hollow rod ☐ Jetted ☐ Bored ☐ Reverse rotary		
5. Type and color of material				8. Use: ☐ Domestic ☐ Public supply ☐ Industry ☐ Irrigation ☐ Air conditioning ☐ Stock ☒ Lawn ☐ Oil field water ☐ Other		
				9. Casing: Material <u>PITS</u> Height: Above or below Threaded ☐ Welded <u>91</u> Surface <u>24</u> in. RMP ☒ PVC ☐ Weight ☐ lbs./ft. Dia. <u>5</u> in. to <u>78</u> ft. depth Wall Thickness: inches or Dia. ☐ in. to ☐ ft. depth gage No. <u>20</u>		
				10. Screen: Manufacturer's name <u>SUNFLOWER</u> <u>PITS Pipe</u> Type <u>RMP</u> Dia. <u>5 in</u> Slot/gauze <u>1/16</u> Length <u>20 ft</u> Set between <u>58</u> ft. and <u>78</u> ft. ft. and ☐ ft. Gravel pack? ☒ Size range of material <u>1/2 - 1</u>		
				11. Static water level: ☐ mo./day/yr. <u>19</u> ft. below land surface Date <u>4-22-78</u>		
				12. Pumping level below land surfaces: <u>NA</u> ☐ ft. after ☐ hrs. pumping ☐ g.p.m. ☐ ft. after ☐ hrs. pumping ☐ g.p.m. Estimated maximum yield ☐ g.p.m.		
				13. Water sample submitted: ☐ mo./day/yr. ☐ Yes ☒ No Date ☐		
				14. Well head completion: ☐ Pitless adapter <u>24</u> inches above grade		
				15. Well grouted? ☒ yes With: ☐ Neat cement ☐ Bentonite ☒ Concrete Depth: From <u>0</u> ft. to <u>10</u> ft.		
				16. Nearest source of possible contamination: ft. <u>50</u> Direction <u>SW</u> Type <u>Sept. line</u> Well disinfected upon completion? ☒ Yes ☐ No		
				17. Pump: ☒ Not installed Manufacturer's name ☐ Model number ☐ HP ☐ Volts ☐ Length of drop pipe ☐ ft. capacity ☐ g.p.m. Type: ☐ Submersible ☐ Turbine ☐ Jet ☐ Reciprocating ☐ Centrifugal ☐ Other		
(Use a second sheet if needed)						
18. Elevation:		19. Remarks: <u>concrete skb to be installed</u> <u>by customer at ground level</u>		20. Water well contractor's certification: This well was drilled under my jurisdiction and this report is true to the best of my knowledge and belief. <u>Braddy Waterwells 363</u> Business name <u>Box 217A Douglass Ks</u> License No. <u>1/4 NE SW 1/4</u> Address <u>Richard Braddy</u> Date <u>4-30-78</u> Signed <u>Richard Braddy</u> Authorized representative		
Topography: ☐ Hill ☒ Slope ☐ Upland ☐ Valley						

Forward the white, blue and pink copies to the Department of Health and Environment

Form WWC-5