USE TYPEWRITER OR BALL POINT PEN-PRESS FIRMLY, PRINT CLEARLY.

WATER WELL RECORD
KSA 82a-1201-1215

Kansas Department of Health and Environment-Division of Environment
(Water well Contractors)
Topeka, Kansas 66620

1. Location of well:	County	Fraction	Section number	Township number	Range number
	Sedgwick	1/4 NE 1/4 SE 1/4	1	T 28 S	R 2E E/W

2. Distance and direction from nearest town or city: West of 159th East between Pawnee and 31st South, Lot 26; Pony Meadows.
Street address of well location if in city:

3. Owner of well: Wayne Stewart
R.R. or street: 501 Topaz
City, state, zip code: Wichita, Kansas

4. Locate with "X" in section below: Sketch map: Wichita, Kansas

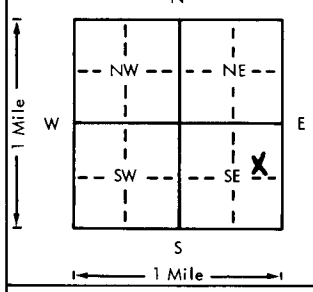

6. Bore hole dia. 11 in. Completion date 8-21-78
Well depth 95 ft.

7. ___ Cable tool X Rotary ___ Driven ___ Dug
___ Hollow rod ___ Jetted ___ Bored ___ Reverse rotary

8. Use: X Domestic ___ Public supply ___ Industry
___ Irrigation ___ Air conditioning ___ Stock
___ Lawn ___ Oil field water ___ Other

9. Casing: Material Styrene Height: Above or below ///
Threaded ___ Welded gl Surface 12 in.
RMP X PVC ___ Weight ___ lbs./ft.
Dia. 5 in. to 95 ft. depth Wall Thickness: inches or
Dia. ___ in. to ___ ft. depth gage No. .200

5. Type and color of material	From	To
Topsoil	0	3
Brown clay	3	7
Light tan clay	7	17
Light tan shale (soft)	17	30
Light grey shale	30	91
Blue shale mixed with white limestone	91	95
(Use a second sheet if needed)		

10. Screen-Manufacturer's name Sunflower plastic
Type styrene Dia. 5"
Slot/gauze /// .06 Length 60'
Set between 35 ft. and 95 ft.
___ ft. and ___ ft.
Gravel pack? yes Size range of material 1/4-1/8"

11. Static water level: mo./day/yr.
32 ft. below land surface Date 8-21-78

12. Pumping level below land surfaces:
___ ft. after ___ hrs. pumping ___ g.p.m.
___ ft. after ___ hrs. pumping ___ g.p.m.
Estimated maximum yield ___ g.p.m.

13. Water sample submitted: mo./day/yr.
___ Yes ___ No Date ___

14. Well head completion: capped
___ Pitless adapter 12 Inches above grade

15. Well grouted? yes 1-2 fine sand mix
With: ___ Neat cement ___ Bentonite X Concrete
Depth: From 40" ft. to 14 ft.

16. Nearest source of possible contamination: None
ft. ___ Direction ___ Type ___
Well disinfected upon completion? X Yes ___ No

17. Pump: X Not installed
Manufacturer's name ___
Model number ___ HP ___ Volts ___
Length of drop pipe ___ ft. capacity ___ g.p.m.
Type:
___ Submersible ___ Turbine
___ Jet ___ Reciprocating
___ Centrifugal ___ Other

18. Elevation:

Topography:
___ Hill
X Slope
___ Upland
___ Valley

19. Remarks:
Septic system not installed at this time
No apparent source for contamination

20. Water well contractor's certification:
This well was drilled under my jurisdiction and this report is true to the best of my knowledge and belief.
Business name Harp Well & Pump License No. 236
Address Wichita, Kansas 67209
Signed M. Arnold Date 10-3-78
Authorized representative

T 28 R 2E Sec 1 1/4 1/4 1/4 NE SE

Forward the white, blue and pink copies to the Department of Health and Environment

Form WWC-5

MI-1023