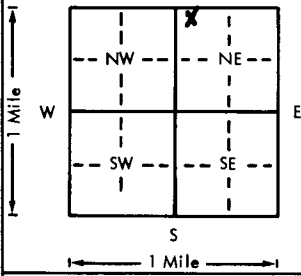


USE TYPEWRITER OR BALL
POINT PEN-PRESS FIRMLY,
PRINT CLEARLY.

WATER WELL RECORD
KSA 82a-1201-1215

Kansas Department of Health and
Environment-Division of Environment
(Water well Contractors)
Topeka, Kansas 66620

1. Location of well:		County Sedgwick	Fraction 1/4 NW 1/4 NE 1/4	Section number 11	Township number T 28 S R	Range number 2E E/W	
2. Distance and direction from nearest town or city: Street address of well location if in city: 13601 E. 31st So. Wichita, Kansas			3. Owner of well: Clark R.R. or street: 13601 E. 31st South City, state, zip code: Wichita, Kansas				
4. Locate with "X" in section below: N W E S 1 Mile		Sketch map: 		6. Bore hole dia. 11 in. Completion date 8-29-77 Well depth 82 ft.			
5. Type and color of material		From		To		7. ☐ Cable tool ☒ Rotary ☐ Driven ☐ Dug ☐ Hollow rod ☐ Jetted ☐ Bored ☐ Reverse rotary	
						8. Use: ☐ Domestic ☐ Public supply ☐ Industry ☐ Irrigation ☐ Air conditioning ☐ Stock ☒ Lawn ☐ Oil field water ☐ Other	
						9. Casing: Material Styrene Height: Above or below 12 ft. Threaded ☐ Welded ☒ Surface ☐ RMP ☒ PVC ☐ Weight ☐ lbs./ft. Dia. 5 in. to 82 ft. depth Wall Thickness: inches or Dia. ☐ in. to ☐ ft. depth Gauge No. 200	
						10. Screen: Manufacturer's name Sunflower Plastic Type styrene Dia. 5" Slot/gauge .06 Length 35' Set between 47 ft. and 82 ft. ft. and ☐ ft. Gravel pack? yes Size range of material 1/2-1/8"	
						11. Static water level: 40 ft. below land surface Date 8-29-77 mo./day/yr.	
(Use a second sheet if needed)						12. Pumping level below land surfaces: ☐ ft. after ☐ hrs. pumping ☐ g.p.m. ☐ ft. after ☐ hrs. pumping ☐ g.p.m. Estimated maximum yield ☐ g.p.m.	
						13. Water sample submitted: ☐ Yes ☐ No Date ☐ mo./day/yr.	
						14. Well head completion: ☐ Pitless adapter 12 capped Inches above grade	
						15. Well grouted? yes 1-2 fine sand mix With: ☐ Neat cement 14 bentonite ☒ Concrete Depth: From ☐ ft. to ☐ ft.	
						16. Nearest source of possible contamination: Septic ft. 200 Direction North Type Tank Well disinfected upon completion? ☒ Yes ☐ No	
						17. Pump: ☒ Not installed Manufacturer's name ☐ Model number ☐ HP ☐ Volts ☐ Length of drop pipe ☐ ft. capacity ☐ g.p.m. Type: ☐ Submersible ☐ Turbine ☐ Jet ☐ Reciprocating ☐ Centrifugal ☐ Other	
						20. Water well contractor's certification: This well was drilled under my jurisdiction and this report is true to the best of my knowledge and belief. Harp Well & Pump 236 Business name License No. Address Wichita, Kansas Signed M. Arnold Date 10-22-77 Authorized representative	
						18. Elevation:	
						19. Remarks: Flat Ground	
						Topography: ☐ Hill ☐ Slope ☐ Upland ☐ Valley	

Forward the white, blue and pink copies to the Department of Health and Environment

Form WWC-5