


1 LOCATION OF WATER WELL: County: SEDGWICK Fraction SE 1/4 SW 1/4 SW 1/4 Section Number 2 Township Number T 28 S Range Number R 2 E/W

Distance and direction from nearest town or city street address of well if located within city? 3140 S REBECCA WICHITA

2 WATER WELL OWNER: RICK GARBARD RR#, St. Address, Box #: 3140 REBECCA W. WICHITA KS Board of Agriculture, Division of Water Resources Application Number:

3 LOCATE WELL'S LOCATION WITH AN "X" IN SECTION BOX:

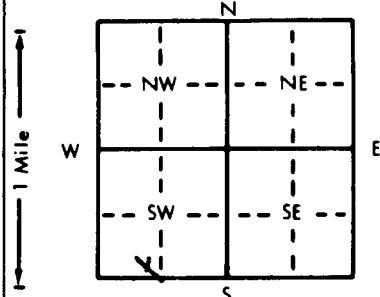

4 DEPTH OF COMPLETED WELL: 66 ft. ELEVATION: WELL'S STATIC WATER LEVEL: 50 ft. below land surface measured on mo/day/yr Pump test data: Well water was ... ft. after ... hours pumping ... gpm Est. Yield ... gpm: Well water was ... ft. after ... hours pumping ... gpm Bore Hole Diameter: 10 in. to 66 ft., and ... in. to ... ft. WELL WATER TO BE USED AS: 1 Domestic (circled), 3 Feedlot, 6 Oil field water supply, 9 Dewatering, 11 Injection well, 2 Irrigation, 4 Industrial, 7 Lawn and garden only, 10 Monitoring well Was a chemical/bacteriological sample submitted to Department? Yes... No... If yes, mo/day/yr sample was submitted Water Well Disinfected? Yes (checked) No

5 TYPE OF BLANK CASING USED: 1 Steel, 2 PVC (circled), 3 RMP (SR), 4 ABS, 5 Wrought iron, 6 Asbestos-Cement, 7 Fiberglass, 8 Concrete tile, 9 Other (specify below), 10 Asbestos-cement, 11 Other (specify), 12 None used (open hole) CASING JOINTS: Glued, Clamped, Welded, Threaded

Blank casing diameter: 5 in. to 46 ft., Dia in. to ... ft., Dia in. to ... ft. Casing height above land surface: 12 in., weight lbs./ft. Wall thickness or gauge No.

TYPE OF SCREEN OR PERFORATION MATERIAL: 1 Steel, 2 Brass, 3 Stainless steel, 4 Galvanized steel, 5 Fiberglass, 6 Concrete tile, 7 PVC, 8 RMP (SR), 9 ABS, 10 Asbestos-cement, 11 Other (specify), 12 None used (open hole)

SCREEN OR PERFORATION OPENINGS ARE: 1 Continuous slot, 2 Louvered shutter, 3 Mill slot, 4 Key punched, 5 Gauzed wrapped, 6 Wire wrapped, 7 Torch cut, 8 Saw cut, 9 Drilled holes, 10 Other (specify), 11 None (open hole)

SCREEN-PERFORATED INTERVALS: From 46 ft. to 66 ft., From ... ft. to ... ft. GRAVEL PACK INTERVALS: From 20 ft. to 66 ft., From ... ft. to ... ft.

6 GROUT MATERIAL: 1 Neat cement, 2 Cement grout, 3 Bentonite (circled), 4 Other Grout intervals: From 3 ft. to 20 ft., From ... ft. to ... ft.

What is the nearest source of possible contamination: 1 Septic tank, 2 Sewer lines, 3 Watertight sewer lines, 4 Lateral lines, 5 Cess pool, 6 Seepage pit, 7 Pit privy, 8 Sewage lagoon (circled), 9 Feedyard, 10 Livestock pens, 11 Fuel storage, 12 Fertilizer storage, 13 Insecticide storage, 14 Abandoned water well, 15 Oil well/Gas well, 16 Other (specify below)

Direction from well? E How many feet? 30+

Table with columns: FROM, TO, LITHOLOGIC LOG, FROM, TO, PLUGGING INTERVALS. Row 1: 0 TD, CLAY & SHALE, 0 66, Cement grout

7 CONTRACTOR'S OR LANDOWNER'S CERTIFICATION: This water well was (1) constructed, (2) reconstructed, or (3) plugged under my jurisdiction and was completed on (mo/day/year) 5/5/92 and this record is true to the best of my knowledge and belief. Kansas Water Well Contractor's License No. 102W This Water Well Record was completed on (mo/day/yr) 8/14/92 under the business name of LAYNE by (signature) [Signature]