USE TYPEWRITER OR BALL POINT PEN-PRESS FIRMLY, PRINT CLEARLY.

WATER WELL RECORD
KSA 82a-1201-1215

Kansas Department of Health and Environment-Division of Environment
(Water well Contractors)
Topeka, Kansas 66620

1. Location of well:	County	Fraction	Section number	Township number	Range number
	Sedgwick	1/4 NW 1/4 NE 1/4	5	T 28 S	R 2E E/W

2. Distance and direction from nearest town or city:
8904 East 31st South
Street address of well location if in city: Wichita, Kansas

3. Owner of well:
R.R. or street:
City, stote, zip code:
Francis Brown
8904 East 31st South
Wichita, Kansas

4. Locate with "X" in section below: Sketch map:

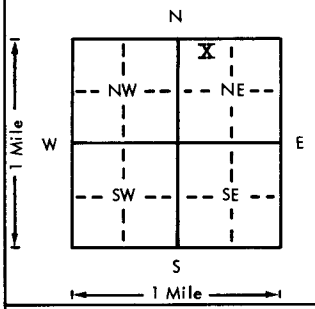

5. Type and color of material	From	To
Topsoil	0	3
Brown Clay	3	15
Yellowish Tan Clay	15	20
Yellowish Tan Soft Shale	20	45
Blue Shale	45	65
Blue Shale Mixed with White Limestone	65	90
(Use a second sheet if needed)		

6. Bore hole dia. 11 in. Completion date
Well depth 90 ft. 4-11-77

7. __ Cable tool X Rotary __ Driven __ Dug
__ Hollow rad __ Jetted __ Bored __ Reverse rotary

8. Use: X Domestic __ Public supply __ Industry
__ Irrigation __ Air conditioning __ Stock
__ Lawn __ Oil field water __ Other

9. Casing: Material Styrene Height: Above or below
Threaded __ Welded gl Surface 12 in.
RMP X PVC __ Weight __ lbs./ft.
Dia. 5 in. to 90 ft. depth Wall Thickness: inches or
Dia. __ in. to __ ft. depth gage No. .200

10. Screen: Manufacturer's name Sunflower Plastic
Type Styrene Dia. 5"
Slot/gauze .06 Length 60'
Set between 30 ft. and 90 ft.
__ ft. and __ ft.
Gravel pack? yes Size range of material 1/4-1/8"

11. Static water level: mo./day/yr.
30 ft. below land surface Date 4-11-77

12. Pumping level below land surfaces:
__ ft. after __ hrs. pumping __ g.p.m.
__ ft. after __ hrs. pumping __ g.p.m.
Estimated maximum yield __ g.p.m.

13. Water sample submitted: mo./day/yr.
__ Yes __ No Date

14. Well head completion: capped
__ Pitless adapter 12 Inches above grade

15. Well grouted? yes 1/1 Sand
With: __ Neat cement __ Bentonite X Concrete
Depth: From 40" ft. to 14 ft. OK

16. Nearest source of possible contamination: Septic
ft. 100 Direction West Type Tank
Well disinfected upon completion? X Yes __ No

17. Pump: X Not installed
Manufacturer's name
Model number HP Volts
Length of drop pipe ft. capacity g.p.m.
Type:
__ Submersible __ Turbine
__ Jet __ Reciprocating
__ Centrifugal __ Other

18. Elevation:
Topography:
__ Hill
__ Slope
__ Upland
__ Valley

19. Remarks: Flat Ground

20. Water well contractor's certification:
This well was drilled under my jurisdiction and this report is true to the best of my knowledge and belief.
Harp Well & Pump 236
Business name License No.
Address Wichita, Kansas
Signed M. Arnold Date
Authorized representative 4-30-77

T 28 — R 2E — Sec 5 — 1/4 1/4 1/4 NW NE

Forward the white, blue and pink copies to the Department of Health and Environment

Form WWC-5

M1-1023