


1] LOCATION OF WATER WELL: Fraction SW 1/4 S2 1/4 SE 1/4 Section Number 6 Township Number 28 Range Number 2
 County: Sedgwick
 Distance and direction from nearest town or city street address of well if located within city?

2] WATER WELL OWNER: McConnell AFB
 RR#, St. Address, Box # :
 City, State, ZIP Code: Wichita, Kansas

Board of Agriculture, Division of Water Resources
 Application Number:

3] LOCATE WELL'S LOCATION WITH AN "X" IN SECTION BOX: 4] DEPTH OF COMPLETED WELL: 22.5 ft. ELEVATION: 134.6

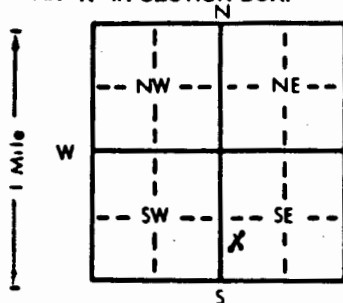

Depth(s) Groundwater Encountered 1. 10.0 ft. 2. 10.0 ft. 3. 10.0 ft.

WELL'S STATIC WATER LEVEL 7.0 ft. below land surface measured on mo/day/yr 11/28/88

Pump test data: Well water was None ft. after None hours pumping None gpi

Est. Yield None gpm: Well water was None ft. after None hours pumping None gpi

Bore Hole Diameter 1.1 in. to 22.5 ft., and None in. to None ft.

WELL WATER TO BE USED AS: 5 Public water supply 8 Air conditioning 11 Injection well

1 Domestic 3 Feedlot 6 Oil field water supply 9 Dewatering 12 Other (Specify below)

2 Irrigation 4 Industrial 7 Lawn and garden only 10 Monitoring well

Was a chemical/bacteriological sample submitted to Department? Yes None No X; If yes, mo/day/yr sample was submitted

Water Well Disinfected? Yes None No X

5] TYPE OF BLANK CASING USED: 5 Wrought iron 8 Concrete tile CASING JOINTS: Glued None Clamped None

1 Steel 3 RMP (SR) 6 Asbestos-Cement 9 Other (specify below) Welded None

2 PVC 4 ABS 7 Fiberglass Threaded None

Blank casing diameter 2 in. to 5.9 ft., Dia None in. to None ft., Dia None in. to None ft.

Casing height above land surface None in., weight None lbs./ft. Wall thickness or gauge No. See 4.0

TYPE OF SCREEN OR PERFORATION MATERIAL: 7 PVC 10 Asbestos-cement

1 Steel 3 Stainless steel 5 Fiberglass 8 RMP (SR) 11 Other (specify)

2 Brass 4 Galvanized steel 6 Concrete tile 9 ABS 12 None used (open hole)

SCREEN OR PERFORATION OPENINGS ARE: 5 Gauzed wrapped 8 Saw cut 11 None (open hole)

1 Continuous slot 3 Mill slot 6 Wire wrapped 9 Drilled holes

2 Louvered shutter 4 Key punched 7 Torch cut 10 Other (specify)

SCREEN-PERFORATED INTERVALS: From 5.9 ft. to 19.9 ft., From None ft. to None ft.

From None ft. to None ft., From None ft. to None ft.

GRAVEL PACK INTERVALS: From 3.9 ft. to 22.5 ft., From None ft. to None ft.

From None ft. to None ft., From None ft. to None ft.

6] GROUT MATERIAL: 1 Neat cement 2 Cement grout 3 Bentonite 4 Other Cement/Bentonite

Grout intervals: From 1.0 ft. to 2.0 ft., From 2.0 ft. to 3.9 ft., From None ft. to None ft.

What is the nearest source of possible contamination: 10 Livestock pens 14 Abandoned water well

1 Septic tank 4 Lateral lines 7 Pit privy 11 Fuel storage 15 Oil well/Gas well

2 Sewer lines 5 Cess pool 8 Sewage lagoon 12 Fertilizer storage 16 Other (specify below)

3 Watertight sewer lines 6 Seepage pit 9 Feedyard 13 Insecticide storage Unknown

Direction from well? How many feet?

FROM TO LITHOLOGIC LOG FROM TO PLUGGING INTERVALS

0 1.0 Clay - Lt Br In None None

1.0 7.0 Clay - Bl to DK Gr Br None None

7.0 10.0 Clay - DK Br Damp None None

10.0 17.0 " - Rd Br w/ gravel wet None None

17.0 18.0 " - Br Sat Damp None None

18.0 22.5 " - Bl to Rd Br Si Damp None None

RECEIVED RECEIVED

OCT 27 1989

JUN 15 1989

DIVISION OF ENVIRONMENT

CONTRACTOR'S OR LANDOWNER'S CERTIFICATION: This water well was (1) constructed (2) reconstructed, or (3) plugged under my jurisdiction and was completed on (mo/day/year) 11/12/88 and this record is true to the best of my knowledge and belief. Kansas Water Well Contractor's License No. 494 This Water Well Record was completed on (mo/day/yr) 11/19/89 under the business name of Southwestern Lab by (signature) Robert L. [Signature]