Well No. MLF1-MW5

WATER WELL RECORD Form WWC-5 KSA 82a-1212

1 LOCATION OF WATER WELL:
County: Sedgwick
Fraction: NW ¼ NE ¼ SE ¼
Section Number: 7
Township Number: T 29 S
Range Number: R 2 (E)W
Distance and direction from nearest town or city street address of well if located within city? 28

2 WATER WELL OWNER: McConnell AFB
RR#, St. Address, Box # :
City, State, ZIP Code : Wichita, Kansas

Board of Agriculture, Division of Water Resource
Application Number:

3 LOCATE WELL'S LOCATION WITH AN "X" IN SECTION BOX:

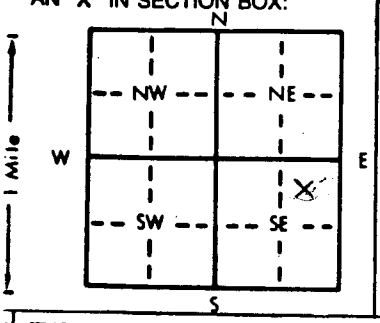

4 DEPTH OF COMPLETED WELL 15.0 ft. ELEVATION: 1340
Depth(s) Groundwater Encountered 1. 14.5 ft. 2. ft. 3. ft.
WELL'S STATIC WATER LEVEL 3.48 ft. below land surface measured on mo/day/yr 11/30/88
Pump test data: Well water was None ft. after hours pumping gpm
Est. Yield gpm: Well water was ft. after hours pumping gpm
Bore Hole Diameter in. to ft., and in. to ft.
WELL WATER TO BE USED AS: 1 Domestic 2 Irrigation 3 Feedlot 4 Industrial 5 Public water supply 6 Oil field water supply 7 Lawn and garden only 8 Air conditioning 9 Dewatering 10 Monitoring well 11 Injection well 12 Other (Specify below) ✓
Was a chemical/bacteriological sample submitted to Department? Yes No X; If yes, mo/day/yr sample was submitted
Water Well Disinfected? Yes No X

5 TYPE OF BLANK CASING USED: 1 Steel 2 PVC 3 RMP (SR) 4 ABS 5 Wrought iron 6 Asbestos-Cement 7 Fiberglass 8 Concrete tile 9 Other (specify below)
CASING JOINTS: Glued Clamped Welded Threaded ✓
Blank casing diameter 2 in. to 5.5 ft., Dia in. to ft., Dia in. to ft.
Casing height above land surface in., weight lbs./ft. Wall thickness or gauge No. Sch. 40

TYPE OF SCREEN OR PERFORATION MATERIAL: 1 Steel 2 Brass 3 Stainless steel 4 Galvanized steel 5 Fiberglass 6 Concrete tile 7 PVC 8 RMP (SR) 9 ABS 10 Asbestos-cement 11 Other (specify) 12 None used (open hole)
SCREEN OR PERFORATION OPENINGS ARE: 1 Continuous slot 2 Louvered shutter 3 Mill slot 4 Key punched 5 Gauzed wrapped 6 Wire wrapped 7 Torch cut 8 Saw cut 9 Drilled holes 10 Other (specify) 11 None (open hole)
SCREEN-PERFORATED INTERVALS: From 5.5 ft. to 14.5 ft., From ft. to ft.
From ft. to ft., From ft. to ft.
GRAVEL PACK INTERVALS: From 4.5 ft. to 15.0 ft., From ft. to ft.
From ft. to ft., From ft. to ft.

6 GROUT MATERIAL: 1 Neat cement 2 Cement grout 3 Bentonite 4 Other Cement/Bentonite
Grout Intervals: From 2.0 ft. to 2.0 ft., From 2.0 ft. to 4.5 ft., From ft. to ft.
What is the nearest source of possible contamination:
1 Septic tank 2 Sewer lines 3 Watertight sewer lines 4 Lateral lines 5 Cess pool 6 Seepage pit 7 Pit privy 8 Sewage lagoon 9 Feedyard 10 Livestock pens 11 Fuel storage 12 Fertilizer storage 13 Insecticide storage 14 Abandoned water well 15 Oil well/Gas well 16 Other (specify below) Unknown
Direction from well? How many feet?

FROM	TO	LITHOLOGIC LOG	FROM	TO	PLUGGING INTERVALS
0	1.5	Silt – Dr Br Cl Damp			
1.5	10.0	Clay – Dr Br Moist			
10.0	15.0	" – " " Saturated			

RECEIVED JUN 15 1989 DIVISION OF ENVIRONMENT

RECEIVED OCT 27 1989 DIVISION OF ENVIRONMENT

7 CONTRACTOR'S OR LANDOWNER'S CERTIFICATION: This water well was (1) constructed, (2) reconstructed, or (3) plugged under my jurisdiction and was completed on (mo/day/year) 10/31/88 and this record is true to the best of my knowledge and belief. Kansas Water Well Contractor's License No. 494 This Water Well Record was completed on (mo/day/yr) 11/18/88 under the business name of Southwestern Lab by (signature) [signature]

INSTRUCTIONS: Use typewriter or ball point pen. *PLEASE PRESS FIRMLY* and *PRINT* clearly. Please fill in blanks, underline or circle the correct answers. Send top three copies to Kansas Department of Health and Environment, Bureau of Water Protection, Topeka, Kansas 66620-7320. Telephone: 913-296-5514. Send one to WATER WELL OWNER and retain one for your records.

FIGURE 3.3

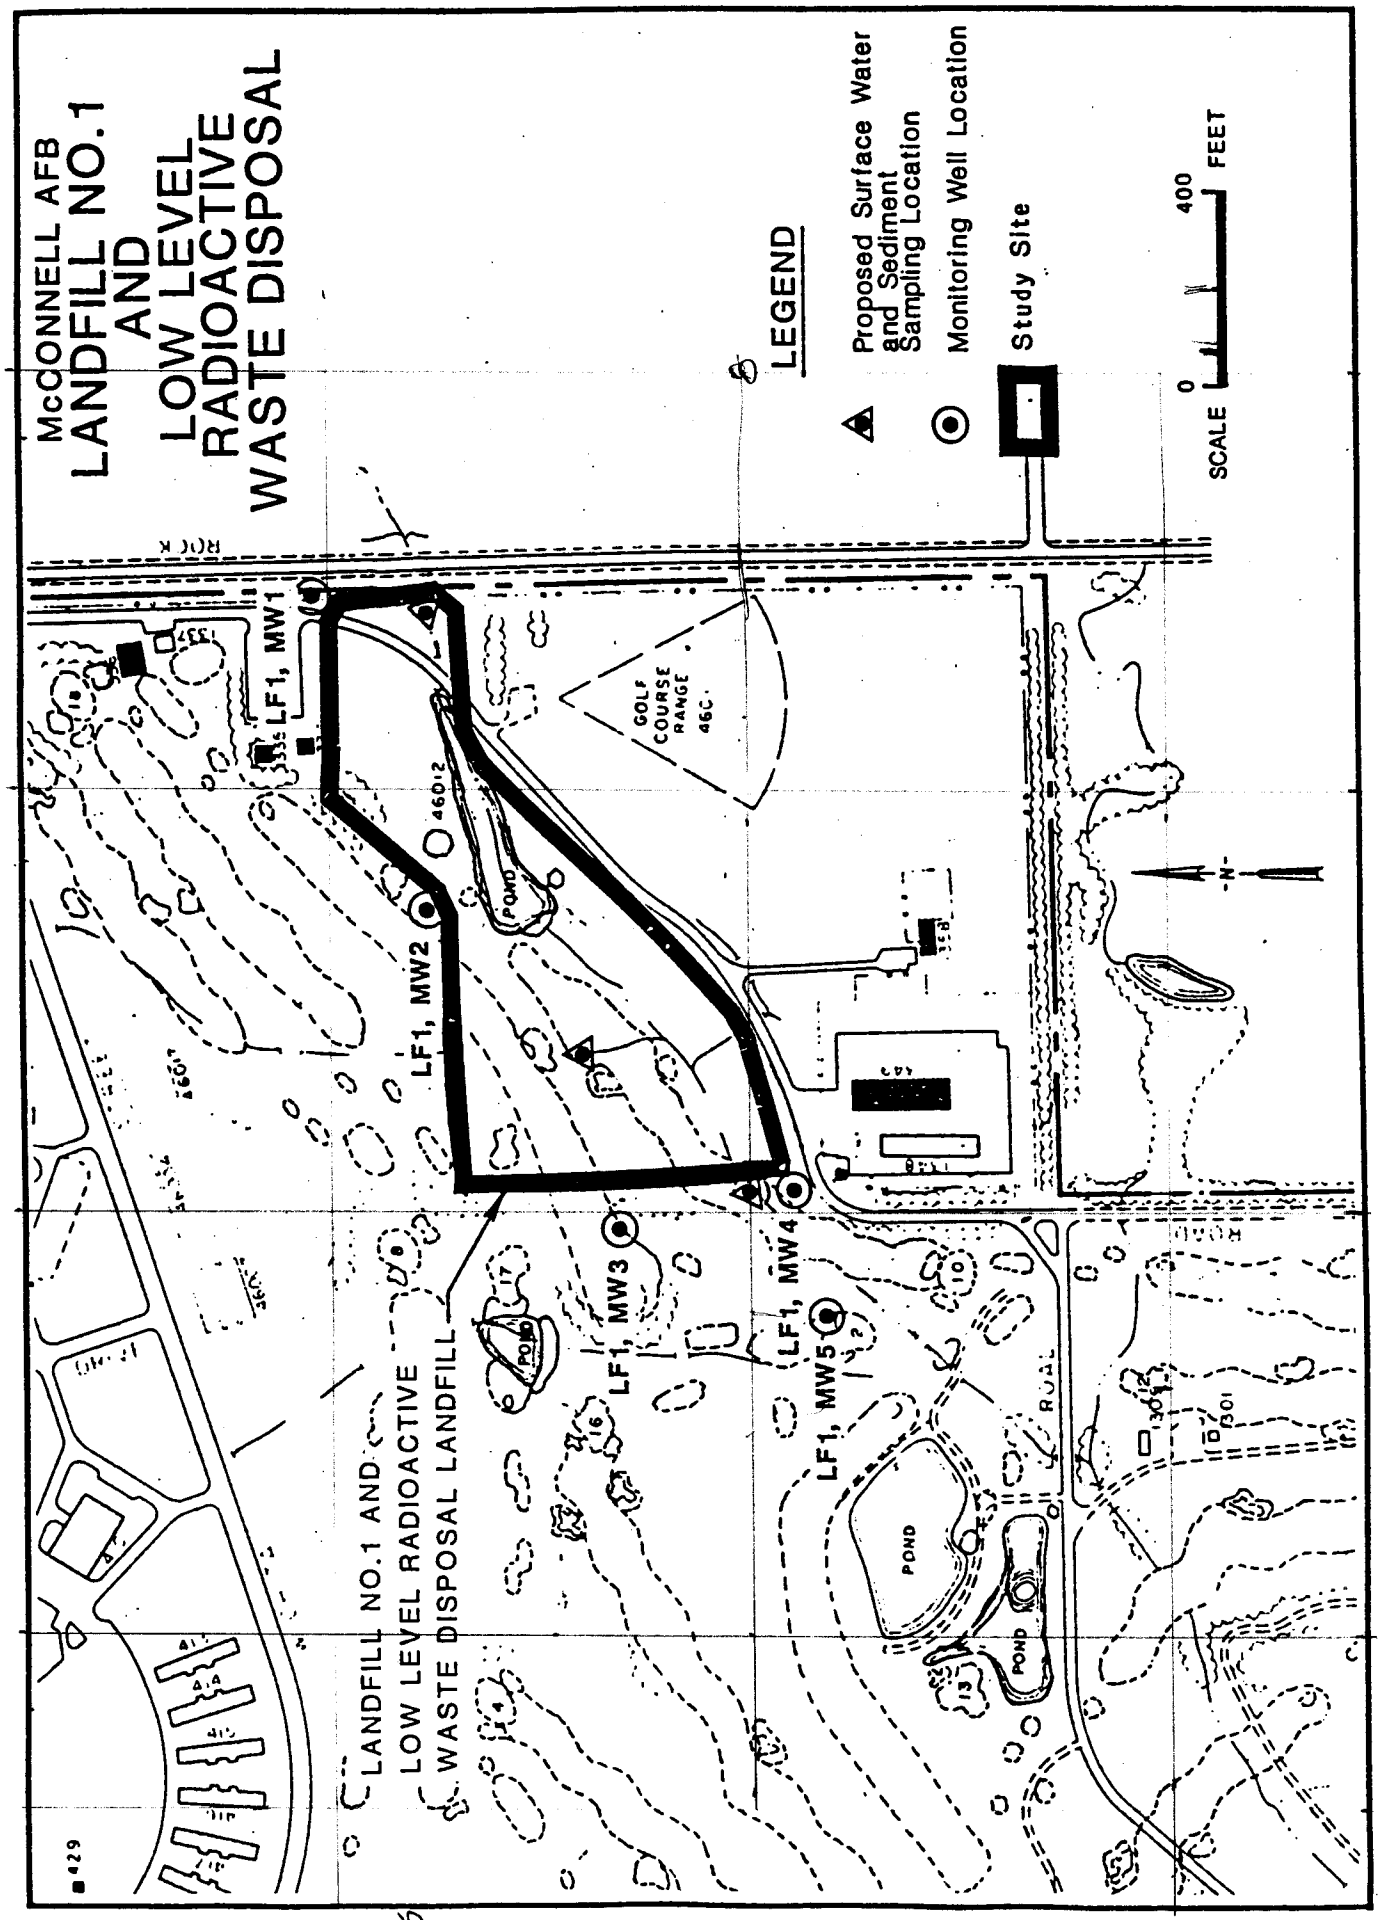

ES ENGINEERING-SCIENCE