USE TYPEWRITER OR BALL POINT PEN-PRESS FIRMLY, PRINT CLEARLY.

WATER WELL RECORD
KSA 82a-1201-1215

Kansas Department of Health and Environment-Division of Environment
(Water well Contractors)
Topeka, Kansas 66620

| 1. Location of well: | County | Fraction | Section number | Township number | Range number |
|---|---|---|---|---|---|
| | Sedgwick | 1/4 NE 1/4 NW 1/4 | 9 | T 28 S | R 2E E/W |

2. Distance and direction from nearest town or city: 10003 East 31st street South
Street address of well location if in city: Wichita, Kansas

3. Owner of well: E.E. Haynes
R.R. or street: 1120 West 33rd Street North
City, state, zip code: Wichita, Kansas

4. Locate with "X" in section below:

Sketch map:

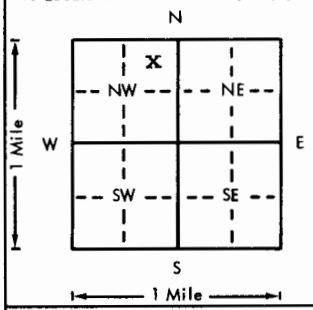


6. Bore hole dia. 11 in. Completion date
Well depth 80 ft. 6-10-77

7. __ Cable tool X Rotary __ Driven __ Dug
__ Hollow rod __ Jetted __ Bored __ Reverse rotary

8. Use: X Domestic __ Public supply __ Industry
__ Irrigation __ Air conditioning __ Stock
__ Lawn __ Oil field water __ Other

9. Casing: Material Styrene Height: Above or below
Threaded ___ Welded gl Surface 12 in.
RMP X PVC ___ Weight ___ lbs./ft.
Dia. 5 in. to 80 ft. depth Wall Thickness: inches or
Dia. ___ in. to ___ ft. depth gage No. .200

| 5. Type and color of material | From | To |
|---|---|---|
| Topsoil | 0 | 3 |
| Clay yellow | 3 | 40 |
| Brown Shale | 40 | 71 |
| Limestone | 71 | 80 |

(Use a second sheet if needed)

10. Screen: Manufacturer's name Sunflower Plastic
Type Styrene Dia. 5"
Slot/gauze .06 Length 40'
Set between 40 ft. and 80 ft.
___ ft. and ___ ft.
Gravel pack? yes Size range of material ¼-1/8"

11. Static water level: mo./day/yr.
40 ft. below land surface Date 6-10-77

12. Pumping level below land surfaces:
___ ft. after ___ hrs. pumping ___ g.p.m.
___ ft. after ___ hrs. pumping ___ g.p.m.
Estimated maximum yield ___ g.p.m.

13. Water sample submitted: mo./day/yr.
___ Yes ___ No Date

14. Well head completion:
X Pitless adapter 12 Inches above grade

15. Well grouted? yes 1 to 2 fine sand mix
With: ___ Neat cement ___ Bentonite X Concrete
Depth: From 40" ft. to 14 ft.

16. Nearest source of possible contamination: NONE
ft. ___ Direction ___ Type ___
Well disinfected upon completion? X Yes ___ No

17. Pump: ___ Not installed
Manufacturer's name Sta-Rite
Model number 8P4C02 HP ½ Volts 230
Length of drop pipe 75 ft. capacity 8 g.p.m.
Type:
X Submersible ___ Turbine
___ Jet ___ Reciprocating
___ Centrifugal ___ Other

18. Elevation:

Topography:
___ Hill
___ Slope
X Upland
___ Valley

19. Remarks: Septic System was not installed when the well was drilled.
No apparent source for contamination.

20. Water well contractor's certification:
This well was drilled under my jurisdiction and this report is true to the best of my knowledge and belief.
Harp Well & Pump 236
Business name License No.
Address Wichita, Kansas
Signed M. Arnold Date 6-21-77
Authorized representative

T 28 R 2 (E) W Sec 9 1/4 1/4 1/4 NE NW

Forward the white, blue and pink copies to the Department of Heolth and Environment

Form WWC-5

M1-1023