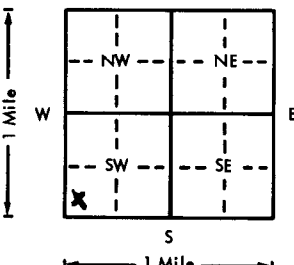
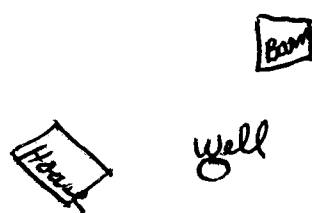


USE TYPEWRITER OR BALL
POINT PEN-PRESS FIRMLY,
PRINT CLEARLY.

WATER WELL RECORD
KSA 82a-1201-1215

Kansas Department of Health and
Environment-Division of Environment
(Water well Contractors)
Topeka, Kansas 66620

1. Location of well:		County <u>Sedgwick</u>	Fraction <u>SW 1/4 SW 1/4 SW 1/4</u>	Section number <u>13</u>	Township number T <u>28</u> S R <u>2</u> <u>EN</u>	Range number
2. Distance and direction from nearest town or city: <u>3 N. 2 W</u> Street address of well location if in city: <u>Rosehill</u>			3. Owner of well: <u>Fred Ruth</u> R.R. or street: City, state, zip code: <u>Wichita Kansas</u>			
4. Locate with "X" in section below:		Sketch map:		6. Bore hole dia. <u>10</u> in. Completion date <u>8-6-1976</u> Well depth <u>125</u> ft.		
				7. ☒ Cable tool ☐ Rotary ☐ Driven ☐ Dug ☐ Hollow rod ☐ Jetted ☐ Bored ☐ Reverse rotary		
5. Type and color of material		From		To		8. Use: ☒ Domestic ☐ Public supply ☐ Industry ☐ Irrigation ☐ Air conditioning ☒ Stock ☐ Lawn ☐ Oil field water ☐ Other
Brown Clay		0		18		9. Casing: Material <u>plb</u> Height: <u>Above</u> or below Threaded ☐ Welded ☒ Surface <u>2 ft</u> RMP ☒ PVC ☐ Weight <u>2.87</u> lbs./ft. Dia. <u>6</u> in. to <u>125</u> ft. depth Wall Thickness: inches or Dia. <u>6</u> in. to <u>125</u> ft. depth gauge No. <u>2175</u>
yellow soap stone		18		34		10. Screen: Manufacturer's name <u>g & z</u> Type <u>RMP</u> Dia. <u>6 in</u> Slot/gauze <u>1/16</u> Length <u>20 ft</u> Set between <u>105</u> ft. and <u>135</u> ft. ft. and <u>135</u> ft. Gravel pack? <u>No</u> Size range of material <u> </u>
yellow shale		34		51		11. Static water level: <u>63</u> ft. below land surface Date <u>8-6-1976</u> mo./day/yr.
grey shale		51		73		12. Pumping level below land surfaces: ft. after <u> </u> hrs. pumping <u> </u> g.p.m. ft. after <u> </u> hrs. pumping <u> </u> g.p.m. Estimated maximum yield <u>20 ft</u> g.p.m.
Red shale		73		76		13. Water sample submitted: <u> </u> mo./day/yr. Yes ☐ No ☒ Date <u> </u>
yellow shale		76		112		14. Well head completion: Pitless adapter <u>2 ft</u> inches above grade
water		112		15. Well grouted? <u>yes</u> With: ☒ Neat cement ☐ Bentonite ☐ Concrete Depth: From <u>0</u> ft. to <u>12</u> ft.		
yellow lime		112		16. Nearest source of possible contamination: ft. <u> </u> Direction <u> </u> Type <u> </u> Well disinfected upon completion? ☒ Yes ☐ No		
				17. Pump: ☒ Not installed Manufacturer's name <u> </u> Model number <u> </u> HP <u> </u> Volts <u> </u> Length of drop pipe <u> </u> ft. capacity <u> </u> g.p.m. Type: ☐ Submersible ☐ Turbine ☐ Jet ☐ Reciprocating ☐ Centrifugal ☐ Other		
18. Elevation:		19. Remarks: <u>owner will put on slab</u>		20. Water well contractor's certification: This well was drilled under my jurisdiction and this report is true to the best of my knowledge and belief. <u>Wibe well drilling 122</u> Business name <u>R#3 Bot 128 Augusta</u> License No. <u> </u> Address <u> </u> <u>Kan</u> Signed <u>Murray Wibe</u> Date <u>8-6-1976</u> Authorized representative		

Forward the white, blue and pink copies to the Department of Health and Environment

Form WWC-5