USE TYPEWRITER OR BALL POINT PEN-PRESS FIRMLY, PRINT CLEARLY.

WATER WELL RECORD
KSA 82a-1201-1215

Kansas Department of Health and Environment-Division of Environment
(Water well Contractors)
Topeka, Kansas 66620

NW SE SE SW

1. Location of well:	County	Fraction	Section number	Township number	Range number
	Sedgwick	NE 1/4 NW 1/4 NW 1/4	13	T 28 S	R 2E E/W

2. Distance and direction from nearest town or city: 15010 East 47st South
Street address of well location if in city: Wichita, Kansas

3. Owner of well: Terry Millegan Constr.
R.R. or street: 643 North Pershing
City, state, zip code: Wichita, Kansas

4. Locate with "X" in section below:

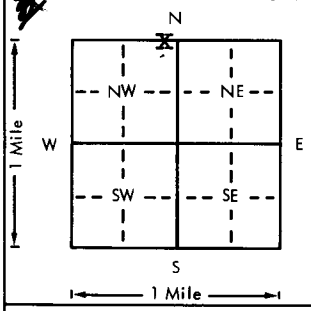

Sketch map:

5. Type and color of material	From	To
Topsoil	0	3
Clay	3	16
Gray Shale	16	98

(Use a second sheet if needed)

6. Bore hole dia. 11 in. Completion date 4-11-77
Well depth 98 ft.

7. ___ Cable tool X Rotary ___ Driven ___ Dug
___ Hollow rod ___ Jetted ___ Bored ___ Reverse rotary

8. Use: X Domestic ___ Public supply ___ Industry
___ Irrigation ___ Air conditioning ___ Stock
___ Lawn ___ Oil field water ___ Other

9. Casing: Material Styrene Height: Above or below
Threaded ___ Welded gl Surface 12 in.
RMP X PVC ___ Weight ___ lbs./ft.
Dia. 5 in. to 98 ft. depth Wall Thickness: inches or
Dia. ___ in. to ___ ft. depth gage No. .200

10. Screen: Manufacturer's name Sunflower Plastic
Type Styrene Dia. 5"
Slot/gauze .06 Length 58'
Set between 40 ft. and 98 ft.
___ ft. and ___ ft.
Gravel pack? yes Size range of material 1/4-1/8"

11. Static water level: 35 ft. below land surface Date 4-11-77 mo./day/yr.

12. Pumping level below land surfaces:
___ ft. after ___ hrs. pumping ___ g.p.m.
___ ft. after ___ hrs. pumping ___ g.p.m.
Estimated maximum yield ___ g.p.m.

13. Water sample submitted: ___ Yes ___ No Date ___ mo./day/yr.

14. Well head completion: Well Seal
___ Pitless adapter 12 Inches above grade

15. Well grouted? yes
With: ___ Neat cement ___ Bentonite X Concrete
Depth: From 6 ft. to 16 ft.

16. Nearest source of possible contamination: NONE
ft. ___ Direction ___ Type ___
Well disinfected upon completion? X Yes ___ No

17. Pump: ___ Not installed
Manufacturer's name Sta-Rite
Model number 20P4E02 HP 1 Volts 230
Length of drop pipe 85 ft. capacity 20 g.p.m.
Type:
___ Submersible ___ Turbine
___ Jet ___ Reciprocating
___ Centrifugal ___ Other

18. Elevation:

Topography:
___ Hill
X Slope
___ Upland
___ Valley

19. Remarks: Septic system not Installed when well was drilled.

No apparent source for contamination.

Well to be in the Basement.

20. Water well contractor's certification:
This well was drilled under my jurisdiction and this report is true to the best of my knowledge and belief.
Business name Harp Well & Pump Service License No. 236
Address Wichita, Kansas
Signed M. Arnold Date 7-18-77
Authorized representative

Sec 13 T 28 R 2 W 1/4 NE 1/4 NW 1/4

Forward the white, blue and pink copies to the Department of Health and Environment

Form WWC-5

MI-1023