USE TYPEWRITER OR BALL POINT PEN-PRESS FIRMLY, PRINT CLEARLY.

WATER WELL RECORD
KSA 82a-1201-1215

Kansas Department of Health and Environment-Division of Environment
(Water well Contractors)
Topeka, Kansas 66620

1. Location of well:	County	Fraction	Section number	Township number	Range number
	Sedgwick	Lot 2 SW 1/4 SW 1/4 1/4	22	T 28 S	R 2E E/W

2. Distance and direction from nearest town or city: 2 mi. N of Rose Hill, Kansas & 4 mi. W. N. side of Road
Street address of well location if in city:

3. Owner of well:
R.R. or street: Dan Carney & George Hall
City, state, zip code: P. O. Box 18422 Wichita, Kansas 67218

4. Locate with "X" in section below:

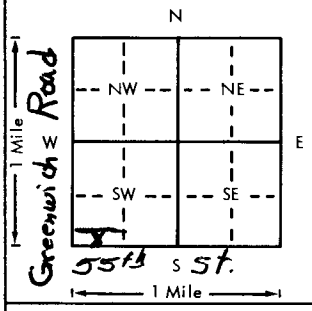

Sketch map:

6. Bore hole dia. 11 in. Completion date 6-21-79
Well depth 60 ft.

7. X Cable tool __ Rotary __ Driven __ Dug
__ Hollow rod __ Jetted __ Bored __ Reverse rotary

8. Use: X Domestic __ Public supply __ Industry
__ Irrigation __ Air conditioning __ Stock
__ Lawn __ Oil field water __ Other

9. Casing: Material Plas Height: Above or below
Threaded __ Welded __ Surface 14 in.
RMP __ PVC __ Weight X lbs./ft.
Dia. 8 in. to 60 ft. depth Wall Thickness: inches or
Dia. __ in. to __ ft. depth gage No. 322

5. Type and color of material	From	To
Soil	0	1
Red Clay	1	4
White Clay	4	14
Buff Clay	14	30
Gray Shale	30	38
Buff Lime-water	38	45
Buff Shale	45	50
Gray Shale	50	60
(Use a second sheet if needed)		

10. Screen: Manufacturer's name
Type Slots Dia. 8"
Slat/gauze 1/8 Length 20'
Set between 40 ft. and 60 ft.
ft. and ft.
Gravel pack? X Size range of material ¼"

11. Static water level: mo./day/yr.
32 ft. below land surface Date 6-20-79

12. Pumping level below land surfaces:
ft. after hrs. pumping g.p.m.
ft. after hrs. pumping g.p.m.
Estimated maximum yield 40 g.p.m.

13. Water sample submitted: mo./day/yr.
__ Yes X No Date

14. Well head completion:
__ Pitless adapter Inches above grade

15. Well grouted? yes
With: X Neat cement __ Bentonite __ Concrete
Depth: From 2 ft. to 19 ft.

16. Nearest source of possible contamination:
ft. none Direction Type
Well disinfected upon completion? X Yes __ No

17. Pump: X Not installed
Manufacturer's name
Model number HP Volts
Length of drop pipe ft. capacity g.p.m.
Type:
__ Submersible __ Turbine
__ Jet __ Reciprocating
__ Centrifugal __ Other

T 28 — R 2E — Sec 22 — 1/4 1/4 1/4 SW

18. Elevation:

Topography:
__ Hill
__ Slope
X Upland
__ Valley

19. Remarks:
Carney & Hall will install the 4x4 concrete slab.

20. Water well contractor's certification:
This well was drilled under my jurisdiction and this report is true to the best of my knowledge and belief.
Business name Abraham & Plummer License No. 181A
Address Leon, Ks. 67074
Signed Jay Abraham Authorized representative Date 6-26-79

Forward the white, blue and pink copies to the Department of Health and Environment

Form WWC-5

Certain-teed 8" P.V.C. -1120 SDR-26-160 BST (ASTM-D2241-NSF-PW-02FK 1M6)

MI-1023