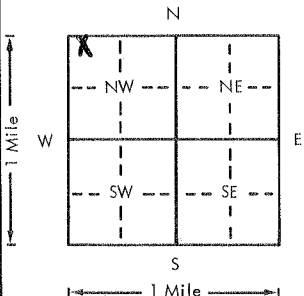


USE TYPEWRITER OR BALL
POINT PEN-PRESS FIRMLY,
PRINT CLEARLY.

WATER WELL RECORD
KSA 82a-1201-1215

Kansas Department of Health and
Environment-Division of Environment
(Water well Contractors)
Topeka, Kansas 66620

1. Location of well:	County Sedgwick	Fraction 1/4 NW 1/4 NW 1/4	Section number 25	Township number T 28 S R	Range number 2E E/W
2. Distance and direction from nearest town or city: Street address of well location if in city: 14523 East 55th South Rose Hill, Kansas			3. Owner of well: Jack Ralph R.R. or street: 14523 East 55th South City, state, zip code: Rose Hill, Kansas		
4. Locate with "X" in section below:  Sketch map:			6. Bore hole dia. 11 in. Completion date _____ Well depth 90 ft. 7-19-78		
			7. ☒ Cable tool ☒ Rotary ☐ Driven ☐ Dug ☐ Hollow rod ☐ Jetted ☐ Bored ☐ Reverse rotary		
			8. Use: ☒ Domestic ☐ Public supply ☐ Industry ☐ Irrigation ☐ Air conditioning ☐ Stock ☐ Lawn ☐ Oil field water ☐ Other		
			9. Casing: Material Styrene Height: Above or below 46' Threaded ☐ Welded ☒ Surface 12 in. RMP ☒ PVC ☐ Weight _____ lbs./ft. Dia. 5 in. to 90 ft. depth Wall Thickness: inches or Dia. _____ in. to _____ ft. depth gage No. 200		
5. Type and color of material			From	To	
Topsoil			0	3	10. Screen: Manufacturer's name Sunflower plastic
Clay			3	10	Type styrene Dia. 5"
Brown shale			10	65	Slot/gauze 1/4" .06 Length 40'
Grey shale			65	90	Set between 50 ft. and 90 ft.
					_____ ft. and _____ ft.
					Gravel pack? yes Size range of material 1/4-1/8"
					11. Static water level: _____ mo./day/yr. 55 ft. below land surface Date 7-19-78
					12. Pumping level below land surfaces: _____ ft. after _____ hrs. pumping _____ g.p.m. _____ ft. after _____ hrs. pumping _____ g.p.m. Estimated maximum yield _____ g.p.m.
					13. Water sample submitted: _____ mo./day/yr. Yes _____ No _____ Date _____
					14. Well head completion: _____ capped _____ Pitless adapter 12 inches above grade
					15. Well grouted? yes 1-2 fine sand mix With: _____ Neat cement _____ Bentonite ☒ Concrete Depth: From 40" ft. to 14 ft.
					16. Nearest source of possible contamination: ft. _____ Direction _____ Type None Well disinfected upon completion? ☒ Yes _____ No
					17. Pump: ☒ Not installed Manufacturer's name _____ Model number _____ HP _____ Volts _____ Length of drop pipe _____ ft. capacity _____ g.p.m. Type: ☐ Submersible ☐ Turbine ☐ Jet ☐ Reciprocating ☐ Centrifugal ☐ Other
(Use a second sheet if needed)					
18. Elevation:		19. Remarks:		20. Water well contractor's certification:	
Topography: ____ Hill ____ Slope ____ Upland ____ Valley		Flat ground Septic system not installed at this time No apparent source for contamination		This well was drilled under my jurisdiction and this report is true to the best of my knowledge and belief. Harp Well & Pump 236 Business name Address Wichita, Kansas 67209 License No. Signed M. Arnold Date 10-4-78 Authorized representative	

Forward the white, blue and pink copies to the Department of Health and Environment

Form WWC-5