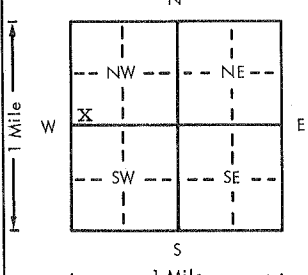


USE TYPEWRITER OR BALL
POINT PEN-PRESS FIRMLY,
PRINT CLEARLY.

WATER WELL RECORD
KSA 82a-1201-1215

Kansas Department of Health and
Environment-Division of Environment
(Water well Contractors)
Topeka, Kansas 66620

1. Location of well:		County Sedgwick	Fraction 1/4 SW 1/4 NW 1/4	Section number 25	Township number T 28 S R 2E E/W
2. Distance and direction from nearest town or city: Street address of well location if in city: 5850 South 143rd East Wichita, Kansas			3. Owner of well: Harold Osterloh Sr. R.R. or street: 1515 South Pattie City, state, zip code: Wichita, Kansas		
4. Locate with "X" in section below: Sketch map: 			6. Bore hole dia. 11 in. Completion date 7-11-77 Well depth 85 ft.		
5. Type and color of material			7. ☒ Cable tool ☒ Rotary ☐ Driven ☐ Dug ☐ Hollow rod ☐ Jetted ☐ Bored ☐ Reverse rotary		
			8. Use: ☒ Domestic ☐ Public supply ☐ Industry ☐ Irrigation ☐ Air conditioning ☐ Stock ☐ Lawn ☐ Oil field water ☐ Other		
			9. Casing: Material Styrene Height: Above or below 61 ft. Threaded ☐ Welded ☒ Surface 12 in. RMP ☒ PVC ☐ Weight 12 lbs./ft. Dia. 5 in. to 85 ft. depth Wall Thickness: inches or Dia. 5 in. to 85 ft. depth gage No. 200		
			10. Screen: Manufacturer's name Sunflower Plastic Type Styrene Dia. 5" Slot 1/16" Length 60' Set between 25 ft. and 85 ft. Gravel pack? yes Size range of material 1/4-1/8"		
			11. Static water level: 20 ft. below land surface Date 7-11-77 12. Pumping level below land surfaces: ____ ft. after ____ hrs. pumping ____ g.p.m. ____ ft. after ____ hrs. pumping ____ g.p.m. Estimated maximum yield ____ g.p.m.		
13. Water sample submitted: ____ mo./day/yr. ____ Yes ____ No Date ____			14. Well head completion: Capped ____ Pitless adapter 12 inches above grade		
15. Well grouted? yes to 2 fine sandmix. With: ____ Neat cement ____ Bentonite ☒ Concrete Depth: From 40" ft. to 14 ft.			16. Nearest source of possible contamination: Septic ft. 200 Direction West Type Tank Well disinfected upon completion? ☒ Yes ____ No		
17. Pump: ☒ Not installed Manufacturer's name ____ Model number ____ HP ____ Volts ____ Length of drop pipe ____ ft. capacity ____ g.p.m. Type: ____ Submersible ____ Turbine ____ Jet ____ Reciprocating ____ Centrifugal ____ Other			20. Water well contractor's certification: This well was drilled under my jurisdiction and this report is true to the best of my knowledge and belief. Harp Well & Pump 236 Business name License No. Address Wichita, Kansas Signed M. Arnold Date 7-29-77 Authorized representative		
18. Elevation:		19. Remarks:			
Topography: ☐ Hill ☒ Slope ☐ Upland ☐ Valley					

Forward the white, blue and pink copies to the Department of Health and Environment

Form WWC-5