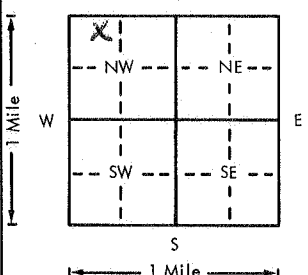


USE TYPEWRITER OR BALL
POINT PEN-PRESS FIRMLY,
PRINT CLEARLY.

WATER WELL RECORD
KSA 82a-1201-1215

Kansas Department of Health and
Environment-Division of Environment
(Water well Contractors)
Topeka, Kansas 66620

1. Location of well:		County: <u>Sedgwick</u>	Fraction: <u>1/4 1/4 NW 1/4</u>	Section number: <u>25</u>	Township number: <u>T 28 S</u>	Range number: <u>R 2 EW</u>
2. Distance and direction from nearest town or city: <u>2 N 1 2/3 W</u>		3. Owner of well: <u>J. L. Ralph</u>		R.R. or street: <u>Route 2</u>		
Street address of well location if in city: <u>Rosehill</u>		City, state, zip code: <u>Derby Kans</u>				
4. Locate with "X" in section below:		Sketch map:		6. Bore hole dia. <u>10</u> in. Completion date <u>8-7-1976</u>		
				Well depth <u>100</u> ft.		
				7. ☒ Cable tool ☐ Rotary ☐ Driven ☐ Dug ☐ Hollow rod ☐ Jetted ☐ Bored ☐ Reverse rotary		
				8. Use: ☒ Domestic ☐ Public supply ☐ Industry ☐ Irrigation ☐ Air conditioning ☐ Stock ☐ Lawn ☐ Oil field water ☐ Other		
				9. Casing: Material <u>galv</u> Height: <u>Above</u> or below Threading <u>Welded</u> Surface <u>16</u> in. RMP ☒ PVC <u>gal</u> Weight <u>16</u> lbs./ft. Dia. <u>6</u> in. to <u>100</u> ft. depth Wall Thickness: inches or Dia. <u>6</u> in. to <u>100</u> ft. depth gage No. <u>175</u>		
5. Type and color of material		From	To	10. Screen: Manufacturer's name <u>JL</u>		
<u>Brown Clay</u>		<u>0</u>	<u>8</u>	Type <u>RMP</u> Dia. <u>6 in</u>		
<u>yellow shale</u>		<u>8</u>	<u>54</u>	Slat/gauze <u>1/16 80</u> Length <u>20 ft</u>		
<u>Red shale</u>		<u>54</u>	<u>59</u>	Set between <u> </u> ft. and <u>100</u> ft.		
<u>grey shale</u>		<u>59</u>	<u>74</u>	Gravel pack? <u>no</u> Size range of material <u> </u>		
<u>Blue shale</u>		<u>74</u>	<u>85</u>	11. Static water level: <u>65</u> ft. below land surface Date <u>8-7-1976</u>		
<u>grey lime</u>		<u>85</u>	<u>90</u>	12. Pumping level below land surfaces: <u> </u> ft. after <u> </u> hrs. pumping <u> </u> g.p.m. <u> </u> ft. after <u> </u> hrs. pumping <u> </u> g.p.m. Estimated maximum yield <u>20+</u> g.p.m.		
<u>water</u>		<u>90</u>		13. Water sample submitted: <u> </u> mo./day/yr. <u> </u> Yes ☒ No <u> </u> Date <u> </u>		
<u>grey lime</u>		<u>90</u>	<u>100</u>	14. Well head completion: <u> </u> Pitless adapter <u>16</u> Inches above grade		
				15. Well grouted? <u>yes</u> With: <u> </u> Neat cement <u> </u> Bentonite <u> </u> Concrete <u> </u> Depth: From <u>0</u> ft. to <u>12</u> ft.		
				16. Nearest source of possible contamination: ft. <u> </u> Direction <u> </u> Type <u> </u> Well disinfected upon completion? ☒ Yes <u> </u> No <u> </u>		
				17. Pump: <u> </u> ☒ Not installed Manufacturer's name <u> </u> Model number <u> </u> HP <u> </u> Volts <u> </u> Length of drop pipe <u> </u> ft. capacity <u> </u> g.p.m. Type: <u> </u> Submersible <u> </u> Turbine <u> </u> Jet <u> </u> Reciprocating <u> </u> Centrifugal <u> </u> Other <u> </u>		
18. Elevation:		19. Remarks: <u>owner will put on slab</u> <u>John Ralph</u>		20. Water well contractor's certification: This well was drilled under my jurisdiction and this report is true to the best of my knowledge and belief. <u>Wike Well Drilling</u> 122 Business name <u> </u> License No. <u> </u> Address <u>Rt 3 Box 1286 Augusta</u> Signed <u>Harvey Wike</u> Date <u>8-7-1976</u> Authorized representative		

Forward the white, blue and pink copies to the Department of Health and Environment

Form WWC-5