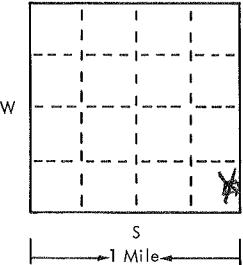
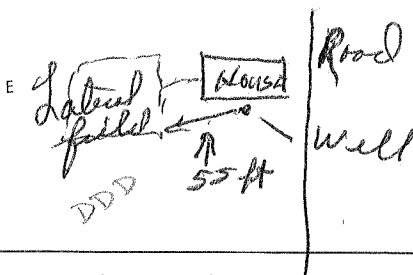


USE TYPEWRITER OR BALL
POINT PEN-PRESS FIRMLY,
PRINT CLEARLY.

WATER WELL RECORD
KSA 82a-1201-1215

T R EW sec 1/4 1/4 1/4 No.

Kansas State Dept. Of Health
(Water Well Contractors)
Forbes-Bldg. 740
Topeka, Kansas 66620

1 Location of well:	County <u>Sedgwick</u>	Township name	Fraction <u>SE 1/4 SE 1/4 SE 1/4</u>	Section number <u>26</u>	Town number <u>28S</u>	Range number <u>2E</u>	
Distance and direction from nearest town or city: <u>1 MI NORTH, 2 MI WEST, 1/8 MI NORTH ROSE HILL KANSAS</u>				3 Owner of well: <u>Isobor R Lambert</u> Address: <u>WICHITA, K.S.</u>			
Locate with "X" in section below: N 		Sketch map: 		4 Well depth: <u>47</u> ft. Date of completion <u>4-9-75</u> Well diameter <u>8</u> in.			
2 Type and color of material		From		To		5 ☒ Cable tool ☐ Rotary ☐ Driven ☐ Dug ☐ Hollow rod ☐ Jetted ☐ Bored ☐ Reverse rotary	
						6 Use: ☒ Domestic ☐ Public supply ☐ Industry ☐ Irrigation ☐ Air conditioning ☐ Commercial ☐ Test well ☐	
						7 Casing: Material <u>PLASTIC</u> Height: <u>above</u> below Threading ☐ Welded ☐ Surface <u>12</u> in. Digm. <u>RMP</u> Weight <u> </u> lbs./ft. <u>6</u> in. to <u>27</u> ft. depth Drive shoe? ☐ Yes ☒ No <u> </u> in. to <u> </u> ft. depth	
						8 Screen: Manufacturer <u>Superflow Plastics</u> Type <u>100 RMP</u> Dia. <u>6</u> " Slot/gauze <u>Dimpled</u> Length <u>20</u> ' Set between <u>27</u> ft. and <u>47</u> ft. Fittings: <u>3/4" x 1" nipple</u> Gravel pack ☒ Yes ☐ No Size range of material <u> </u>	
						9 Static water level: <u>20</u> ft. below land surface Date <u>4-9-75</u>	
(use a second sheet if needed)						10 Pumping level below land surfaces: <u> </u> ft. after <u> </u> hrs. pumping <u> </u> g.p.m. <u> </u> ft. after <u> </u> hrs. pumping <u> </u> g.p.m. Estimated maximum yield <u>25</u> g.p.m.	
						11 Water sample submitted: ☐ Yes ☒ No Date <u> </u>	
						12 Well head completion: ☒ Pitless adapter ☐ Inches above grade <u>12"</u>	
						13 Well grouted? ☐ Yes ☐ No ☒ Neat cement ☐ Bentonite ☐ Depth: From <u>3 1/2</u> ft. to <u>16</u> ft.	
						14 Nearest source of possible contamination: ft. <u>55</u> Direction <u>West</u> Type <u>Septic tank</u> Well disinfected upon completion? ☒ Yes ☐ No	
16 Remarks: elevation Topography: ☐ Hill ☐ Slope ☒ Upland ☐ Valley						15 Pump: ☐ Not installed Manufacturer's name <u>F+L</u> Model number <u>SBAB</u> HP <u>1/2</u> Volts <u>230</u> Length of drop pipe <u>40</u> ft. capacity <u>10</u> g.m.p. Type: ☒ Submersible ☐ Turbine ☐ Jet ☐ Reciprocating ☐ Centrifugal ☐ Other	
						17 Water well contractor's certification: This well was drilled under my jurisdiction and this report is true to the best of my knowledge and belief. <u>SIMMONS DRILLING 162</u> Business name <u>USE Central ANDOVER</u> License No. <u> </u> Address <u>Ben Bruggen</u> Signed <u>Ben Bruggen</u> Date <u>4-9-75</u> Authorized representative <u>by DUB</u>	
						Forward the white, blue and pink copies to the Kansas State Dept. Of Health.	
						Form WWC-5	
						677-H	