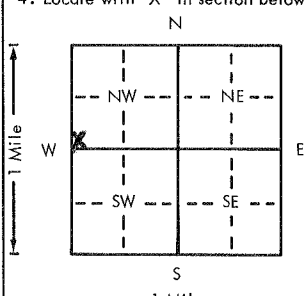
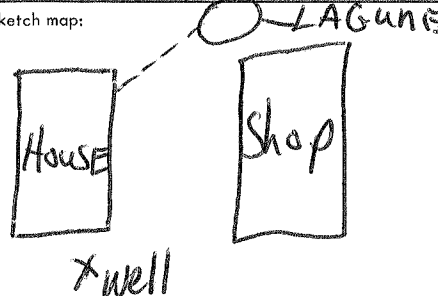


USE TYPEWRITER OR BALL
POINT PEN-PRESS FIRMLY,
PRINT CLEARLY.

WATER WELL RECORD
KSA 82a-1201-1215

Kansas Department of Health and
Environment-Division of Environment
(Water well Contractors)
Topeka, Kansas 66620

1. Location of well:		County: <u>Sedgwick</u>	Fraction: <u>SW 1/4 SW 1/4 NW 1/4</u>	Section number: <u>26</u>	Township number: <u>T 28 S R 2 E</u>	Range number: <u>2</u>
2. Distance and direction from nearest town or city: Street address of well location if in city: <u>5800 So 127th E. Wichita</u>				3. Owner of well: <u>FRED COLLINS</u> R.R. or street: <u>Box 541</u> City, state, zip code: <u>Derby, KS 67037</u>		
4. Locate with "X" in section below:		Sketch map:		6. Bore hole dia. <u>4</u> in. Completion date: <u>10/4/77</u> Well depth <u>87</u> ft.		
				7. ☐ Cable tool ☒ Rotary ☐ Driven ☐ Dug ☐ Hollow rod ☐ Jetted ☐ Bored ☐ Reverse rotary		
5. Type and color of material				8. Use: ☒ Domestic ☐ Public supply ☐ Industry ☐ Irrigation ☐ Air conditioning ☐ Stock ☐ Lawn ☐ Oil field water ☐ Other		
				9. Casing: Material <u>PVC</u> Height <u>Above</u> or below Threaded ☐ Welded ☒ Surface <u>1 1/2</u> in. RMP ☐ PVC ☒ Weight <u>21 1/2</u> lbs./ft. Dia. <u>5</u> in. to <u>8 1/2</u> ft. depth Wall Thickness: inches or Dia. <u>5</u> in. to <u>8 1/2</u> ft. depth gage No. <u>2.31</u>		
				10. Screen: Manufacturer's name <u>M.P.I.</u> Type <u>PVC</u> Dia. <u>5 in</u> Slot gauge <u>1/40</u> Length <u>60 ft</u> Set between <u>30</u> ft. and <u>80</u> ft. ft. and <u>80</u> ft. Gravel pack? ☒ Size range of material <u>3/8</u>		
				11. Static water level: <u>927</u> ft. below land surface Date <u>10/4/77</u>		
				12. Pumping level below land surfaces: <u>32</u> ft. after <u>1 1/2</u> hrs. pumping <u>20</u> g.p.m. <u> </u> ft. after <u> </u> hrs. pumping <u> </u> g.p.m. Estimated maximum yield <u>40</u> g.p.m.		
				13. Water sample submitted: <u> </u> mo./day/yr. ☐ Yes ☒ No Date <u> </u>		
				14. Well head completion: ☒ Pitless adapter <u>12</u> inches above grade		
				15. Well grouted? <u>yes</u> With: ☒ Neat cement ☐ Bentonite ☐ Concrete Depth: From <u>3</u> ft. to <u>13</u> ft.		
				16. Nearest source of possible contamination: ft. <u>200</u> Direction <u>NE</u> Type <u>Lagoon</u> Well disinfected upon completion? ☒ Yes ☐ No		
				17. Pump: Manufacturer's name <u>VATLEY</u> Not installed Model number <u>1206</u> HP <u>1/2</u> Volts <u>220</u> Length of drop pipe <u>60</u> ft. capacity <u>12</u> g.p.m. Type: ☒ Submersible ☐ Turbine ☐ Jet ☐ Reciprocating ☐ Centrifugal ☐ Other		
18. Elevation:		19. Remarks: <u>Customer to pour 4x4x4 reinforced slab at top of well on grade</u>		20. Water well contractor's certification: This well was drilled under my jurisdiction and this report is true to the best of my knowledge and belief. <u>Weninger Dilling</u> 31P Business name <u>Sedgwick KS</u> License No. <u> </u> Address <u> </u> Signed <u> </u> Date <u>10/4/77</u> Authorized representative		

Forward the white, blue and pink copies to the Department of Health and Environment

Form WWC-5