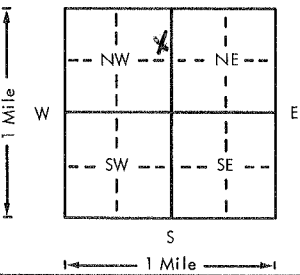


USE TYPEWRITER OR BALL
POINT PEN-PRESS FIRMLY,
PRINT CLEARLY.

WATER WELL RECORD
KSA 82a-1201-1215

Kansas Department of Health and
Environment-Division of Environment
(Water well Contractors)
Topeka, Kansas 66620

1. Location of well:		County Sedgwick	Fraction 1/4 NE 1/4NW 1/4	Section number 28	Township number T 28 S	Range number R 2E E/W
2. Distance and direction from nearest town or city: Street address of well location if in city: 5731 S. 103rd E. Wichita, Kansas			3. Owner of well: Don & Pierre Construction R.R. or street: 1515 Georgia City, state, zip code: Wichita, Kansas 67216			
4. Locate with "X" in section below: 			Sketch map:		6. Bore hole dia. 11 in. Completion date 10-15-77 Well depth 75 ft.	
5. Type and color of material			From		To	
			Topsoil		0	3
			Clay		3	25
			Grey Shale		25	75
					7. Cable tool ☒ Rotary ☐ Driven ☐ Dug ☐ Hollow rod ☐ Jetted ☐ Bored ☐ Reverse rotary	
					8. Use: ☒ Domestic ☐ Public supply ☐ Industry ☐ Irrigation ☐ Air conditioning ☐ Stock ☐ Lawn ☐ Oil field water ☐ Other	
					9. Casing: Material styrene Height: Above or below Threaded ☐ Welded ☒ Surface 12 in. RMP ☒ PVC ☐ Weight ☐ lbs./ft. Dia. 5 in. to 75 ft. depth Wall Thickness: inches or Dia. ☐ in. to ☐ ft. depth gage No. 200	
					10. Screen: Manufacturer's name Sunflower Plastic Type styrene Dia. 5" Slot/groove .06 Length 40' Set between 35 ft. and 75 ft. ft. and 75 ft. Gravel pack? yes Size range of material 1/4-1/8"	
					11. Static water level: 35 ft. below land surface Date 10-15-77 mo./day/yr.	
					12. Pumping level below land surfaces: ft. after hrs. pumping g.p.m. ft. after hrs. pumping g.p.m. Estimated maximum yield g.p.m.	
					13. Water sample submitted: Yes No Date 10-15-77 mo./day/yr.	
					14. Well head completion: ☒ Pitless adapter 12 inches above grade	
					15. Well grouted? yes 1-2 fine sand mix With: ☐ Neat cement ☐ Bentonite ☒ Concrete Depth: From 40' ft. to 14 ft.	
					16. Nearest source of possible contamination: NONE ft. Direction Type Well disinfected upon completion? ☒ Yes ☐ No	
					17. Pump: ☐ Not installed Manufacturer's name Sta-Rite Model number 20P4D02 HP 3/4 Volts 230 Length of drop pipe 70 ft. capacity 20 g.p.m. Type: ☒ Submersible ☐ Turbine ☐ Jet ☐ Reciprocating ☐ Centrifugal ☐ Other	
					(Use a second sheet if needed)	
18. Elevation: Topography: ☐ Hill ☐ Slope ☐ Upland ☐ Valley		19. Remarks: Flat Ground Septic System not installed when the well was drilled. No apparent source for contamination.		20. Water well contractor's certification: This well was drilled under my jurisdiction and this report is true to the best of my knowledge and belief. Harp Well & Pump 236 Business name Wichita, Kansas License No. Address Signed M. Arnold Date 11-18-77 Authorized representative		

Forward the white, blue and pink copies to the Department of Health and Environment

Form WWC-5