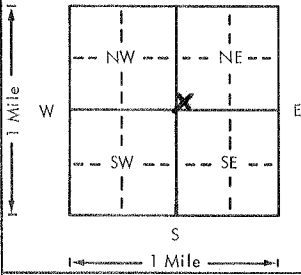


USE TYPEWRITER OR BALL
POINT PEN-PRESS FIRMLY,
PRINT CLEARLY.

WATER WELL RECORD
KSA 82a-1201-1215

Kansas Department of Health and
Environment-Division of Environment
(Water well Contractors)
Topeka, Kansas 66620

1. Location of well: County <u>Sedgewick</u> Fraction <u>SW 1/4 SW 1/4 NE 1/4</u> Section number <u>28</u> Township number <u>T 28 S</u> Range number <u>R 20 W</u>	
2. Distance and direction from nearest town or city: Street address of well location if in city: <u>5928 So 103rd East-</u>	
3. Owner of well: <u>Hepp Sparks</u> R.R. or street: <u>2956 Columbine</u> City, state, zip code: <u>Wichita KS 67204</u>	
4. Locate with "X" in section below: Sketch map: 	
5. Type and color of material	
From To	
<u>Top Soil</u> 0 2	
<u>Red Lst.</u> 2 35	
<u>Charcoal shale</u> 35 80	
6. Bore hole dia. <u>1 1/2</u> in. Completion date <u>3/28/79</u> Well depth <u>80</u> ft.	
7. ☒ Cable tool ☒ Rotary ☐ Driven ☐ Dug ☐ Hollow rod ☐ Jetted ☐ Bored ☐ Reverse rotary	
8. Use: ☒ Domestic ☐ Public supply ☐ Industry ☐ Irrigation ☐ Air conditioning ☐ Stock ☐ Low ☐ Oil field water ☐ Other	
9. Casing: <u>Steel</u> Height <u>12</u> ft. above or below Threaded ☒ Welded ☐ Surface <u>1 1/2</u> in. RMP <u>5</u> PVC ☐ Weight <u>1.50</u> lbs./ft. Dia. <u>5</u> in. to <u>80</u> ft. depth Wall thickness: inches or Dia. <u>5</u> in. to <u>80</u> ft. depth gage No. <u>1200</u>	
10. Screen: Manufacturer's name <u>Sunflower</u> Type <u>200</u> Dia. <u>5</u> in. Slot/auze <u>1/16</u> Length <u>50</u> ft. Set between <u>30</u> ft. and <u>80</u> ft. Gravel pack? <u>Yes</u> Size range of material <u>3/8</u>	
11. Static water level: <u>35</u> ft. below land surface Date <u>3/28/79</u> mo./day/yr.	
12. Pumping level below land surfaces: <u>60</u> ft. after <u>1/2</u> hrs. pumping <u>10</u> g.p.m. <u>60</u> ft. after <u>1</u> hrs. pumping <u>10</u> g.p.m. Estimated maximum yield <u>10</u> <u>15</u> g.p.m.	
13. Water sample submitted: <u>Yes</u> ☒ No ☐ Date <u>3/28/79</u> mo./day/yr.	
14. Well head completion: <u>12</u> inches above grade ☐ Pitless adapter	
15. Well grouted? <u>Yes</u> With: ☐ Neat cement ☐ Bentonite ☒ Concrete Depth: From <u>3</u> ft. to <u>13</u> ft.	
16. Nearest source of possible contamination: <u>Septic</u> ft. <u>60</u> Direction <u>N</u> Type <u>Septic</u> Well disinfected upon completion? ☒ Yes ☐ No	
17. Pump: ☒ Not installed Manufacturer's name _____ Model number _____ HP _____ Volts _____ Length of drop pipe _____ ft. capacity _____ g.p.m. Type: ☐ Submersible ☐ Turbine ☐ Jet ☐ Reciprocating ☐ Centrifugal ☐ Other	
18. Elevation: Topography: ☒ Hill ☐ Slope ☐ Upland ☐ Valley	
19. Remarks: <u>Customer to furnish 4x4x4 slab around well at grade</u> <u>Per State Regulations</u> <u>Signed X Hepp Sparks</u>	
20. Water well contractor's certification: This well was drilled under my jurisdiction and this report is made to the best of my knowledge and belief. Business name <u>Wichita</u> License No. <u>318</u> Address <u>Sedgewick</u> Signed <u>Hepp Sparks</u> Date <u>3/28/79</u> Authorized representative	

Forward the white, blue and pink copies to the Department of Health and Environment

Form WWC-5