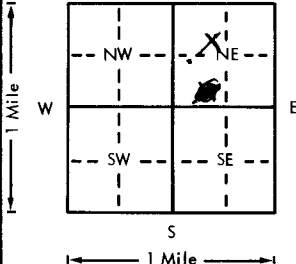
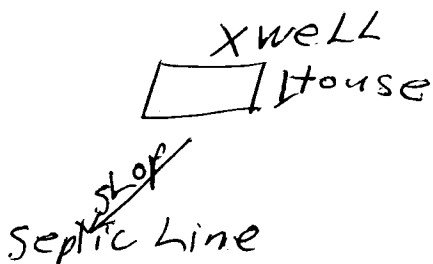


USE TYPEWRITER OR BALL
POINT PEN-PRESS FIRMLY,
PRINT CLEARLY.

WATER WELL RECORD
KSA 82a-1201-1215

Kansas Department of Health and
Environment-Division of Environment
(Water well Contractors)
Topeka, Kansas 66620

1. Location of well:		County <u>Sedgwick</u>	Fraction <u>SE 1/4 NW 1/4 NE 1/4</u>	Section number <u>34</u>	Township number <u>T 28 S</u>	Range number <u>R 2 E</u>
2. Distance and direction from nearest town or city:		<u>3 mile East</u>		3. Owner of well: <u>David Doughtam</u>		
Street address of well location if in city:		<u>of Derby</u>		R.R. or street: <u>122 1/2 Smith Street</u>		
				City, state, zip code: <u>Wichita Kan 67212</u>		
4. Locate with "X" in section below:		Sketch map:		6. Bore hole dia. <u>8</u> in. Completion date <u>6/29/79</u> Well depth <u>105</u> ft.		
				7. ☒ Cable tool ☐ Rotary ☐ Driven ☐ Dug ☐ Hollow rod ☐ Jetted ☐ Bored ☐ Reverse rotary		
5. Type and color of material		From		To		8. Use: ☒ Domestic ☐ Public supply ☐ Industry ☐ Irrigation ☐ Air conditioning ☐ Stock ☐ Lawn ☐ Oil field water ☐ Other
						9. Casing: Material <u>PLS</u> Height: Above or below Threaded ☐ Welded ☒ Surface <u>18</u> in. RMP ☒ PVC ☐ Weight <u>100</u> lbs./ft. Dia. <u>5</u> in. to <u>105</u> ft. depth Wall Thickness: inches or Dia. <u>1</u> in. to <u>105</u> ft. depth gage No. <u>115</u>
						10. Screen: Manufacturer's name <u>Sunflower</u> Type <u>199</u> Dia. <u>5</u> Slot/gauze <u>1/16</u> Length <u>20</u> Set between <u>90</u> ft. and <u>90</u> ft. Gravel pack? ☒ Size range of material <u>3/8</u>
						11. Static water level: <u>50</u> ft. below land surface Date <u>6/20/79</u>
						12. Pumping level below land surface: <u>55</u> ft. after <u>1</u> hrs. pumping <u>30</u> g.p.m. <u>30</u> ft. after <u>30</u> hrs. pumping <u>30</u> g.p.m. Estimated maximum yield <u>30</u> g.p.m.
						13. Water sample submitted: <u>Yes</u> ☒ No Date <u>6/20/79</u>
						14. Well head completion: ☐ Pitless adapter ☐ Inches above grade
						15. Well grouted? <u>Yes</u> With: ☐ Neat cement ☐ Bentonite ☒ Concrete Depth: From <u>0</u> ft. to <u>10</u> ft.
						16. Nearest source of possible contamination: ft. <u>50</u> Direction <u>SW</u> Type <u>Septic Line</u> Well disinfected upon completion? <u>Yes</u> Yes ☐ No ☐
						17. Pump: ☒ Not installed Manufacturer's name _____ Model number _____ HP _____ Volts _____ Length of drop pipe _____ ft. capacity _____ g.p.m. Type: _____ ☐ Submersible ☐ Turbine ☐ Jet ☐ Reciprocating ☐ Centrifugal ☐ Other
						18. Elevation:
						19. Remarks:
						20. Water well contractor's certification: This well was drilled under my jurisdiction and this report is true to the best of my knowledge and belief. <u>Winter Well Drilling</u> Business name _____ License No. _____ Address <u>122 Box 30 Augusta</u> Signed <u>Charles W. Smith</u> Date <u>3/14/80</u> Authorized representative