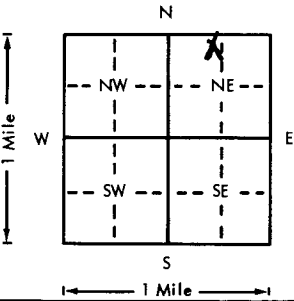


USE TYPEWRITER OR BALL
POINT PEN-PRESS FIRMLY,
PRINT CLEARLY.

WATER WELL RECORD
KSA 82a-1201-1215

Kansas Department of Health and
Environment-Division of Environment
(Water well Contractors)
Topeka, Kansas 66620

1. Location of well:		County: <u>Sedgwick</u>	Fraction: <u>1/4 NW 1/4 NE 1/4</u>	Section number: <u>36</u>	Township number: T <u>28</u> S R <u>2</u> E W
2. Distance and direction from nearest town or city: Street address of well location if in city:		3. Owner of well: <u>Larry Rawles</u> R.R. or street: <u>15309 East 63rd St. South</u> City, state, zip code: <u>Derby, Kansas</u>			
4. Locate with "X" in section below: Sketch map: 		6. Bore hole dia. <u>11</u> in. Completion date <u>7-19-76</u> Well depth <u>100</u> ft.			
5. Type and color of material		7. ☒ Cable tool ☒ Rotary ☐ Driven ☐ Dug ☐ Hollow rod ☐ Jetted ☐ Bored ☐ Reverse rotary			
		8. Use: ☐ Domestic ☐ Public supply ☐ Industry ☐ Irrigation ☐ Air conditioning ☒ Stock ☐ Lawn ☐ Oil field water ☐ Other			
		9. Casing: Material <u>stiprene</u> Height: <u>above</u> or below Threaded ☐ Welded ☒ Surface <u>12</u> in. RMP ☒ PVC ☐ Weight <u> </u> lbs./ft. Dia. <u>5</u> in. to <u>100</u> ft. depth Well Thickness: inches or Dia. <u> </u> in. to <u> </u> ft. depth gage No. <u>2200</u>			
		10. Screen: Manufacturer's name <u>Super Plaster</u> Type <u>stiprene</u> Dia. <u>5</u> in. Slot/gauze <u>.06</u> Length <u>60</u> ft. Set between <u>40</u> ft. and <u>100</u> ft. Gravel pack? ☒ Size range of material <u>1/4-1/8</u>			
		11. Static water level: <u>45</u> ft. below land surface Date <u>7-19-76</u> mo./day/yr.			
		12. Pumping level below land surfaces: _____ ft. after _____ hrs. pumping _____ g.p.m. _____ ft. after _____ hrs. pumping _____ g.p.m. Estimated maximum yield _____ g.p.m.			
		13. Water sample submitted: _____ mo./day/yr. ☐ Yes ☐ No Date _____			
		14. Well head completion: <u>12</u> capped ☐ Pitless adapter _____ inches above grade			
		15. Well grouted? <u>yes</u> With: ☐ Neat cement ☐ Bentonite ☒ Concrete Depth: From <u>40</u> ft. to <u>14</u> ft.			
		16. Nearest source of possible contamination: <u>Septic Tank</u> ft. <u>60</u> Direction <u>SE</u> Type _____ Well disinfected upon completion? ☒ Yes ☐ No			
		17. Pump: ☒ Not installed Manufacturer's name _____ Model number _____ HP _____ Volts _____ Length of drop pipe _____ ft. capacity _____ g.p.m. Type: _____ ☐ Submersible ☐ Turbine ☐ Jet ☐ Reciprocating ☐ Centrifugal ☐ Other			
18. Elevation:		19. Remarks: <u>Flat Ground</u> <u>well to be used to water</u> <u>stock.</u>			
Topography: ☐ Hill ☐ Slope ☐ Upland ☐ Valley		20. Water well contractor's certification: This well was drilled under my jurisdiction and this report is true to the best of my knowledge and belief. <u>Larry Rawles & Pump</u> 236 Business name _____ License No. _____ Address <u>Wichita, Kansas</u> Signed <u>M. Arnold</u> Date <u>8-13-76</u> Authorized representative			