USE TYPEWRITER OR BALL POINT PEN-PRESS FIRMLY, PRINT CLEARLY.

WATER WELL RECORD
KSA 82a-1201-1215

Kansas Department of Health and Environment-Division of Environment
(Water well Contractors)
Topeka, Kansas 66620

1. Location of well:	County	Fraction	Section number	Township number	Range number
	Sedgwick	SE 1/4 NW 1/4 NW 1/4	36	T 28 S	R 2 E/W

2. Distance and direction from nearest town or city: 2W 3/4 N of
Street address of well location if in city: Rose Hill Ks

3. Owner of well: Larry COX
R.R. or street: 1313 W. 32nd So.
City, state, zip code: Wichita Ks, 67217

4. Locate with "X" in section below:

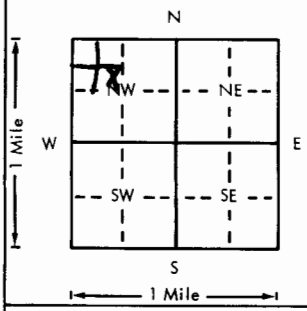

Sketch map:

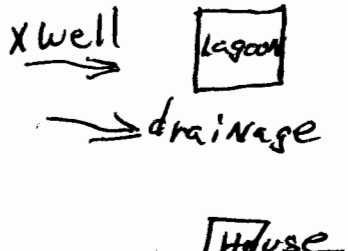

6. Bore hole dia. 8.5 in. Completion date 11-8-78
Well depth 70 ft.

7. X Cable tool __ Rotary __ Driven __ Dug
__ Hollow rod __ Jetted __ Bored __ Reverse rotary

8. Use: X Domestic __ Public supply __ Industry
__ Irrigation __ Air conditioning __ Stock
__ Lawn __ Oil field water __ Other

9. Casing: Material pvc
Threaded ___ Welded glue
RMP X PVC ___
Dia. 5 in. to 70 ft. depth
Dia. ___ in. to ___ ft. depth
Height: Above or below Surface 12 in.
Weight ___ lbs./ft.
Wall Thickness: inches or gage No. 200

10. Screen: Manufacturer's name Sunflower Mfg Inc
Type RMP Dia. 5"
Slot/gauze 1/16 Length 10'
Set between 60 ft. and 70 ft.
___ ft. and ___ ft.
Gravel pack? yes Size range of material 1/8-1/4

11. Static water level: 42 ft. below land surface Date 11-8-78 mo./day/yr.

12. Pumping level below land surfaces: Na
___ ft. after ___ hrs. pumping ___ g.p.m.
___ ft. after ___ hrs. pumping ___ g.p.m.
Estimated maximum yield ___ g.p.m.

13. Water sample submitted: mo./day/yr.
__ Yes X No Date ___

14. Well head completion:
X Pitless adapter 12 Inches above grade

15. Well grouted? yes
With: ___ Neat cement ___ Bentonite X Concrete
Depth: From 13 ft. to 3 ft.

16. Nearest source of possible contamination:
ft. 65 Direction East Type lagoon
Well disinfected upon completion? X Yes ___ No

17. Pump: X Not installed
Manufacturer's name ___
Model number ___ HP ___ Volts ___
Length of drop pipe ___ ft. capacity ___ g.p.m.
Type:
__ Submersible __ Turbine
__ Jet __ Reciprocating
__ Centrifugal __ Other

5. Type and color of material

	From	To
Topsoil	0	1
clay brown	1	4
clay yellow	4	40
clay light lavender	40	45
clay with sandstone yellow brown	45	50
clay light yellow	50	55
clay yellow	55	70
(water at 50')		

(Use a second sheet if needed)

18. Elevation:

Topography:
__ Hill
X Slope
__ Upland
__ Valley

19. Remarks:
owner will Install
concreet slab

20. Water well contractor's certification:
This well was drilled under my jurisdiction and this report is true to the best of my knowledge and belief.
Business name Bradly waterwells License No. 363
Address Box 217 A Douglass Ks
Signed Richard Bradley Date 11-8-78
Authorized representative

28 S — 20 E W — 36 Sec — SE 1/4 NW 1/4 NW 1/4

Forward the white, blue and pink copies to the Department of Health and Environment

Form WWC-5