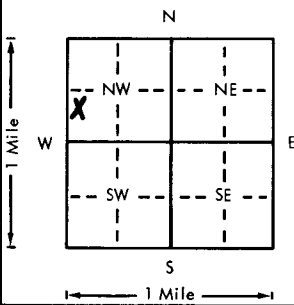


USE TYPEWRITER OR BALL
POINT PEN-PRESS FIRMLY,
PRINT CLEARLY.

WATER WELL RECORD
KSA 82a-1201-1215

Kansas Department of Health and
Environment-Division of Environment
(Water well Contractors)
Topeka, Kansas 66620

1. Location of well:	County Sedgwick	Fraction 1/4 Sw 1/4 NW 1/4	Section number 36	Township number T 28 S	Range number R 2E E/W
2. Distance and direction from nearest town or city: Street address of well location if in city: 6632 South 143rd E. Derby, Kansas			3. Owner of well: Jim Pryor R.R. or street: 6632 South 143rd East City, state, zip code: Derby, Kansas		
4. Locate with "X" in section below: 			Sketch map:		
5. Type and color of material			From	To	6. Bore hole diameter: 11 1/2 in. Completion date: 12-28-77 Well depth: 75 ft.
					7. ☒ Cable tool ☒ Rotary ☐ Driven ☐ Dug ☐ Hollow rod ☐ Jetted ☐ Bored ☐ Reverse rotary
					8. Use: ☒ Domestic ☐ Public supply ☐ Industry ☐ Irrigation ☐ Air conditioning ☐ Stock ☐ Lawn ☐ Oil field water ☐ Other
					9. Casing: Material: styrene Height: Above or below surface: 12 in. Threaded ☐ Welded ☒ Surface 12 in. RMP ☒ PVC ☐ Weight 81 lbs./ft. Dia. 5 in. to 75 ft. depth Wall Thickness: inches or Dia. 5 in. to 75 ft. depth gage No. 200
					10. Screen: Manufacturer's name: Sunflower Plastic Type: styrene Dia. 5" Slot/gage: 0.06 Length 40' Set between 35 ft. and 75 ft. Gravel pack? yes Size range of material: 1/4-1/8"
					11. Static water level: 34 ft. below land surface Date 12-28-77
					12. Pumping level below land surfaces: ____ ft. after ____ hrs. pumping ____ g.p.m. ____ ft. after ____ hrs. pumping ____ g.p.m. Estimated maximum yield ____ g.p.m.
					13. Water sample submitted: ____ mo./day/yr. ____ Yes ____ No Date ____
					14. Well head completion: 12 capped ____ Pitless adapter ____ inches above grade
					15. Well grouted? yes 1-2 fine sand mix With: ____ Neat cement ____ Bentonite ☒ Concrete Depth: From 40' ft. to 14 ft.
					16. Nearest source of possible contamination: Septic ft. 150 Direction N.E. Type Tank Well disinfected upon completion? ☒ Yes ____ No
					17. Pump: ☒ Not installed Manufacturer's name ____ Model number ____ HP ____ Volts ____ Length of drop pipe ____ ft. capacity ____ g.p.m. Type: ____ Submersible ____ Turbine ____ Jet ____ Reciprocating ____ Centrifugal ____ Other
					20. Water well contractor's certification: This well was drilled under my jurisdiction and this report is true to the best of my knowledge and belief. Harp Well & Pump 236 Business name License No. Address Wichita, Kansas 67209 Signed M. Arnold Date 1-10-78 Authorized representative
18. Elevation:	19. Remarks:				
Topography: ____ Hill ☒ Slope ____ Upland ____ Valley					