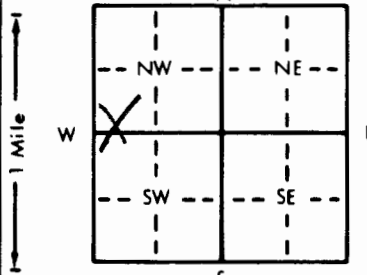


1 LOCATION OF WATER WELL: County: <u>Sedgwick</u> Fraction <u>SW 1/4 SW 1/4 NW 1/4</u> Section Number <u>25</u> Township Number <u>T 28 S</u> Range Number <u>R 2 E</u>					
Distance and direction from nearest town or city street address of well if located within city? <u>2 W 1/2 N of 63rd + Roschill Rd.</u> <u>EAST</u>					
2 WATER WELL OWNER: <u>LEVI EAKHART AREHART</u> RR#, St. Address, Box # : City, State, ZIP Code : <u>AUGUSTA, KS 67010</u> Board of Agriculture, Division of Water Resources Application Number:					
3 LOCATE WELL'S LOCATION WITH AN "X" IN SECTION BOX: 	4 DEPTH OF COMPLETED WELL: <u>80</u> ft. ELEVATION: Depth(s) Groundwater Encountered 1. <u>65</u> ft. 2. <u>65</u> ft. 3. <u>65</u> ft. WELL'S STATIC WATER LEVEL <u>30</u> ft. 


FROM <u>0</u> <u>0</u> <u>15</u> <u>30</u> <u>30</u> <u>40</u>	TO <u>0</u> <u>15</u> <u>30</u> <u>30</u> <u>40</u> <u>80</u>	LITHOLOGIC LOG <u>Earth</u> <u>Brown Clay</u> <u>Gray Shale</u> <u>Red Bed</u> <u>Light Gray Shale</u> <u>DARK Gray Shale</u>	FROM <u>0</u> <u>0</u> <u>15</u> <u>30</u> <u>30</u> <u>40</u>	TO <u>0</u> <u>15</u> <u>30</u> <u>30</u> <u>40</u> <u>80</u>	LITHOLOGIC LOG
7 CONTRACTOR'S OR LANDOWNER'S CERTIFICATION: This water well was (1) constructed, (2) reconstructed, or (3) plugged under my jurisdiction and was completed on (mo/day/year) <u>9/01/85</u> and this record is true to the best of my knowledge and belief. Kansas Water Well Contractor's License No. <u>424</u> This Water Well Record was completed on (mo/day/yr) <u>9/24/85</u> under the business name of <u>FEKERER WELL DRILLING</u> by (signature) <u>Jerry Fekerer</u> INSTRUCTIONS: Use typewriter or ball point pen, PLEASE PRESS FIRMLY and PRINT clearly. Please fill in blanks, underlining or circle the correct answers. Send top three copies to Kansas Department of Health and Environment, Division of Environment, Environmental Geology Section, Topeka, KS 66620. Send one to WATER WELL OWNER and retain one for your records.					